


15-137-20277-00-00

WELL PLUGGING RECORD

Give All Information Completely
 Make Required Affidavit

COUNTY Norton SEC. 10 TWP. 4S RGE. 23 /W
 Location as in quarters or footage from lines:
SE/SE/NW 330' FSL 2310' FEL

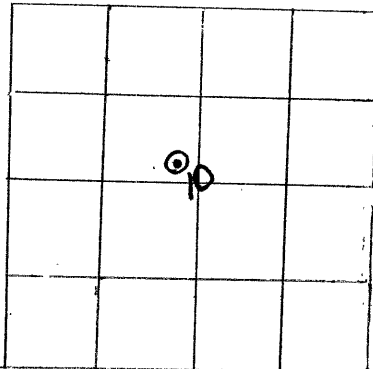

Locate Well
 correctly on above
 Section Platt.

Lease Owner Lee & Anna Henry Irex Corp 05760

Lease Name HENRY Well No. 1

Office Address _____

Character of Well (Completed as Oil, Gas or Dry Hole): P&A'd

Date Well Completed Plugged 3-04-83

Application for plugging filed 3-03-83

Plugging commenced 3-04-83

Plugging completed 3-04-83

Reason for abandonment of well or producing formation _____

Non-productive

Was permission obtained from the Conservation Division or it's
 Agent's before plugging was commenced? Yes

Name of Conservation Agent who supervised plugging of this well Paul Luthi

Producing formation N/A Depth to top -- bottom -- T.D. 3800

Show depth and thickness of all water, oil and gas formations.

OIL, GAS OR WATER RECORDS

Casing Record

Formation	Content	From	To	Size	Put in	Pulled Out
Surface	175 sx.	288	surface	8 5/8"	288'	still in hole

Describe in detail the manner in which the well was plugged, indicating where the mud
 fluid was placed and the method or methods used in introducing it into the hold. If cement
 or other plugs were used, state the character of same and depth placed, from _____ feet
 to _____ feet for each plug set.

1st plug @ 1975' w/ 20 sx. 50/50 poz. 6% gel.
2nd plug @ 1250' w/ 100 sx. 50/50 poz. 6% gel.
3rd plug @ 290' w/ 40 sx. 50/50 poz. 6% gel.
4th plug @ 40' w/ 10 sx. 50/50 poz. 6% gel.
10 sx. in rathole.
Weld on I.D. plate.

RECEIVED
 STATE CORPORATION COMMISSION

APR 18 1983

CONSERVATION DIVISION
 Wichita, Kansas

(If additional description is necessary, use BACK of this sheet)

Name of Plugging Contractor Sun Oil Cementing Co. 4-18-83

STATE OF Colorado COUNTY OF Denver, ss.

I, William H. Bayliff, Operations Mgr (employee of owner) or (owner or operator) of the
 above-described well, being first duly sworn on oath, says: That I have knowledge of the
 facts, statements, and matters herein contained and the log of the above-described well as
 filed and that the same are true and correct. So help me God.

(Signature) William H. Bayliff
1670 Broadway, Suite 3301
Denver, CO (Address) 80202

SUBSCRIBED AND SWORN TO before me this 14th day of April, 19 83

Mary J. Warren
 Notary Public.

My Commission expires: June 9, 1985