


Give All Information Completely  
Make Required Affidavit  
Mail or Deliver Report to:  
Conservation Division  
State Corporation Commission  
212 No. Market  
Wichita, Kansas

WELL PLUGGING RECORD

Norton County, Sec. 10 Twp. 4S Rge. (E) 23 (W)

Location as "NE/CNW $\frac{1}{2}$ SW $\frac{1}{4}$ " or footage from lines. C E/2 NE NE  
Lease Owner Lario Oil & Gas Company  
Lease Name Henry Well No. 1  
Office Address 301 South Market, Wichita, Kansas 67202  
Character of Well (completed as Oil, Gas or Dry Hole) Dry  
Date well completed November 3, 19 69  
Application for plugging filed November 3, 19 69  
Application for plugging approved November 3, 19 69  
Plugging commenced November 3, 19 69  
Plugging completed November 3, 19 69  
Reason for abandonment of well or producing formation D&A

NORTH

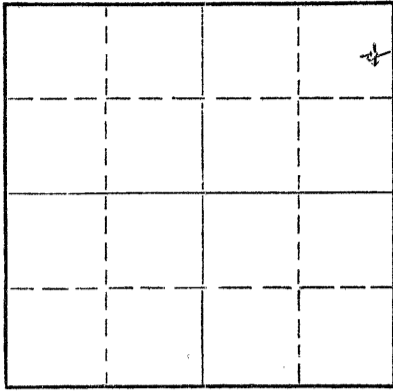

Locate well correctly on above  
Section Plat

If a producing well is abandoned, date of last production 19  
Was permission obtained from the Conservation Division or its agents before plugging was commenced? Yes

Name of Conservation Agent who supervised plugging of this well W. L. Nichols  
Producing formation \_\_\_\_\_ Depth to top \_\_\_\_\_ Bottom \_\_\_\_\_ Total Depth of Well 3700 Feet  
Show depth and thickness of all water, oil and gas formations.

OIL, GAS OR WATER RECORDS

CASING RECORD

FORMATION	CONTENT	FROM	TO	SIZE	PUT IN	PULLED OUT
				8 5/8"	265.57'	None

Describe in detail the manner in which the well was plugged, indicating where the mud fluid was placed and the method or methods used in introducing it into the hole. If cement or other plugs were used, state the character of same and depth placed, from \_\_\_\_\_ feet to \_\_\_\_\_ feet for each plug set.

Plug @ 1125' w/ 70 sxs  
Plug @ 310' w/ 20 sxs  
Plug @ 40' w/ 10 sxs

RECEIVED  
STATE CORPORATION COMMISSION  
NOV 7 1969  
CONSERVATION DIVISION  
Wichita, Kansas

11-7-69

(If additional description is necessary, use BACK of this sheet)  
Name of Plugging Contractor Red Tiger Drilling Company  
Address 1720 Wichita Plaza, Wichita, Kansas 67202

STATE OF Kansas, COUNTY OF Sedgwick, ss.  
G. R. Kelsey (employee of owner) or (owner or operator) of the above-described well, being first duly sworn on oath, says: That I have knowledge of the facts, statements, and matters herein contained and the log of the above-described well as filed and that the same are true and correct. So help me God.

(Signature) [Signature] Div. Prod. Supt.  
301 S. Market, Wichita, Kansas 67202  
(Address)

SUBSCRIBED AND SWORN TO before me this 6th day of November, 19 69

My commission expires July 21, 1970  
Frances Leslie Notary Public.