


Give All Information Completely
Make Required Affidavit
Mail or Deliver Report to:
Conservation Division
State Corporation Commission
800 Bitting Building
Wichita, Kansas

WELL PLUGGING RECORD

15-137-00185-00-00

23W

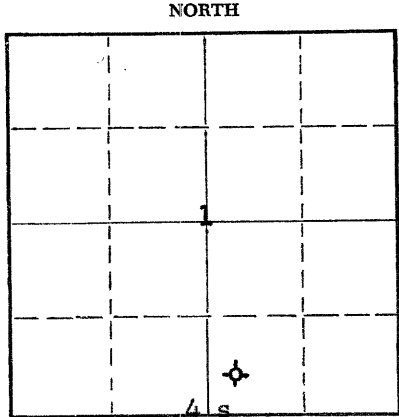

Locate well correctly on above
Section Plat

Norton County. Sec. 1 Twp. 4S Rge. (E) 23(W)

Location as "NE/CNW%SW%" or footage from lines SW/4 SW/4 SE/4

Lease Owner Walters Drilling Co., et al

Lease Name Rife Well No. 1

Office Address 510 Orpheum Building, Wichita 2, Kansas

Character of Well (completed as Oil, Gas or Dry Hole) Dry Hole

Date well completed November 11, 1955

Application for plugging filed (verbal) November 11, 1955

Application for plugging approved (verbal) November 11, 1955

Plugging commenced November 11, 1955

Plugging completed November 11, 1955

Reason for abandonment of well or producing formation Dry Hole

If a producing well is abandoned, date of last production 19

Was permission obtained from the Conservation Division or its agents before plugging was commenced? Yes

Name of Conservation Agent who supervised plugging of this well Eldon Petty, Hays, Kansas

Producing formation Depth to top Bottom Total Depth of Well 3732 Feet

Show depth and thickness of all water, oil and gas formations.

OIL, GAS OR WATER RECORDS

CASING RECORD

FORMATION	CONTENT	FROM	TO	SIZE	PUT IN	PULLED OUT
None	None	0	206'	8 5/8"	206'	None

Describe in detail the manner in which the well was plugged, indicating where the mud fluid was placed and the method or methods used in introducing it into the hole. If cement or other plugs were used, state the character of same and depth placed, from feet to feet for each plug set.

Filled hole with mud to 200', set bottom plug at 200' with 1/2 sack Hulls and 15 sacks cement

Filled hole with mud to 40', set top plug at 40' with 1/2 sack Hulls and 10 sacks cement

(If additional description is necessary, use BACK of this sheet)

Name of Plugging Contractor Walters Drilling Co.

Address 510 Orpheum Building, Wichita 2, Kansas

STATE OF KANSAS, COUNTY OF SEDGWICK, ss.

Robert F. Walters (employee of owner) or (owner or operator) of the above-described well, being first duly sworn on oath, says: That I have knowledge of the facts, statements, and matters herein contained and the log of the above-described well as filed and that the same are true and correct. So help me God.

(Signature)

510 Orpheum Building, Wichita, Kansas


(Address)

SUBSCRIBED AND SWORN TO before me this 16th day of November, 1955

My commission expires March 10, 1956

Pauline Hendrickson

Notary Public.

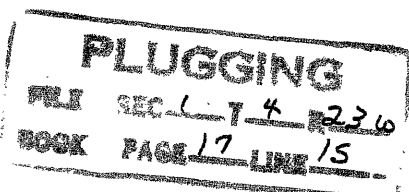

CONSERVATION DIVISION
WICHITA, KANSAS

11-18-55