

15-137-00055-00-00


STATE OF KANSAS  
STATE CORPORATION COMMISSION

WELL PLUGGING RECORD

All Information Completely  
Required Affidavit  
Mail or Deliver Report to:  
Conservation Division  
State Corporation Commission  
800 Biting Building  
Wichita, Kansas

Norton County, Sec. 21 Twp. 4 Rge. 25 (E) W (W)  
Location as "NE/CNW $\frac{1}{4}$ SW $\frac{1}{4}$ " or footage from lines NW-NW-NE  
Lease Owner Harry Gore  
Lease Name Wolf Well No. #1  
Office Address 400 Brown Building, Wichita, Kansas.  
Character of Well (completed as Oil, Gas or Dry Hole) Dry Hole  
Date well completed 10-19 19 51  
Application for plugging filed 10-18 19 51  
Application for plugging approved 10-18 19 51  
Plugging commenced 10-19 12:00 P.M. 19 51  
Plugging completed 10-19 8:00 A.M. 19 51  
Reason for abandonment of well or producing formation Dry Hole

NORTH

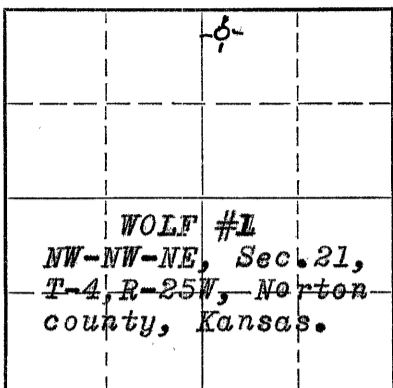

Locate well correctly on above  
Section Plat

If a producing well is abandoned, date of last production 19...  
Was permission obtained from the Conservation Division or its agents before plugging was commenced? Yes Verbal

Name of Conservation Agent who supervised plugging of this well Eldon Petty  
Producing formation \_\_\_\_\_ Depth to top \_\_\_\_\_ Bottom \_\_\_\_\_ Total Depth of Well 4055 Feet  
Show depth and thickness of all water, oil and gas formations.

OIL, GAS OR WATER RECORDS

CASING RECORD

Formation	Content	From	To	Size	Put In	Pulled Out
<u>Soil, clay, shale</u>		<u>0</u>	<u>223</u>	<u>8 5/8"</u>	<u>223'</u>	<u>none</u>
<u>Lansing (K.C.)</u>		<u>3641'</u>	<u>3826'</u>		<u>Dry</u>	<u>Dry</u>
<u>Base (K.C.)</u>		<u>3826'</u>	<u>3995'</u>		<u>Dry</u>	<u>Dry</u>
<u>Arbuckle</u>		<u>3995'</u>	<u>4055'</u>		<u>Dry</u>	<u>Dry</u>

Describe in detail the manner in which the well was plugged, indicating where the mud fluid was placed and the method or methods used in introducing it into the hole. If cement or other plugs were used, state the character of same and depth placed, from \_\_\_\_\_ feet to \_\_\_\_\_ feet for each plug set.

Stirred pits and filled hole with heavy mud. Set bottom wood plug at 210 feet. Ran 1/2 sack Hulls and 15 sacks cement on bottom wood plug. Filled hole with heavy mud to 40 Feet. Ran 1/2 Hulls and 10 sacks cement filling to bottom of cellar.

RECEIVED  
STATE CORPORATION COMMISSION

OCT 26 1951

10-26-51

CONSERVATION DIVISION  
Wichita, Kansas

(If additional description is necessary, use BACK of this sheet)

Name of Plugging Contractor Strain Drilling Company  
Address Box 188, Hays, Kansas.

STATE OF Kansas. COUNTY OF Ellis, ss.  
T.C. Strain (employee of owner) or (owner or operator) of the above-described well, being first duly sworn on oath, says: That I have knowledge of the facts, statements, and matters herein contained and the log of the above-described well as filed and that the same are true and correct. So help me God.

(Signature) T.C. Strain

Box 188, Hays, Kansas.  
(Address)

SUBSCRIBED AND SWORN to before me this 22 day of October, 19 51

My commission expires July 18, 1955 Dorcas Ann Fair Notary Public.

