

15-137-20180-00-00

FORM CP-4


STATE OF KANSAS  
STATE CORPORATION COMMISSION

WELL PLUGGING RECORD

Give All Information Completely  
Make Required Affidavit  
Mail or Deliver Report to  
Conservation Division  
State Corporation Comm.  
245 North Water  
Wichita, KS 67202

Norton County, Sec. 36 Twp. 4S Rge. 23W E/W  
Location as "NE/CNW $\frac{1}{4}$ SW $\frac{1}{4}$ " or footage from lines  
NE NW

Lease Owner Thunderbird Drilling, Inc.  
Lease Name Sprout #1 Well No. \_\_\_\_\_  
Office Address P.O. Box 18407- Wichita, Ks. 67218  
Character of Well (Completed as Oil, Gas or Dry Hole) \_\_\_\_\_  
Dry Hole

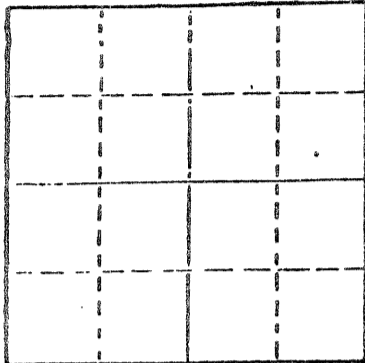

Locate well correctly on above  
Section Plat

Date Well completed 8/17/80 19  
Application for plugging filed 8/17/80 19  
Application for plugging approved 8/17/80 19  
Plugging commenced 8/17/80 19  
Plugging completed 8/17/80 19  
Reason for abandonment of well or producing formation \_\_\_\_\_  
Dry Hole

If a producing well is abandoned, date of last production \_\_\_\_\_ 19

Was permission obtained from the Conservation Division or  
its agents before plugging was commenced? Yes

Name of Conservation Agent who supervised plugging of this well Gilbert Balthazor  
Producing formation \_\_\_\_\_ Depth to top \_\_\_\_\_ Bottom \_\_\_\_\_ Total Depth of Well 3813  
Show depth and thickness of all water, oil and gas formations.

OIL, GAS OR WATER RECORDS

CASING RECORD

FORMATION	CONTENT	FROM	TO	SIZE	PUT IN	PULLED OUT
	Surface			8 5/8"	282'	None

Describe in detail the manner in which the well was plugged, indicating where the mud fluid  
was placed and the method or methods used in introducing it into the hold. If cement or other  
plugs were used, state the character of same and depth placed, from \_\_\_\_\_ feet to  
\_\_\_\_\_ feet for each plug set.

1st plug @ 950' w/70 sx  
2nd plug @ 260' w/20 sx  
Bridge A 40' w/10 sx on top.  
5 sx in rathole, 50-50 poz, 6% gel.

RECEIVED  
STATE CORPORATION COMMISSION

AUG 26 1980

CONSERVATION DIVISION  
Wichita, Kansas

(If additional description is necessary, use BACK of this sheet)

Name of Plugging Contractor Thunderbird Drilling, Inc.

826-80

STATE OF KANSAS COUNTY OF SEDGWICK, ss.  
Burke Krueger (employee of owner) or (owner or operator)  
of the above-described well, being first duly sworn on oath, says: That I have knowledge of  
the facts, statements, and matters herein contained and the log of the above-described well  
as filed and that the same are true and correct. So help me God.

(Signature)

Burke Krueger  
P.O. Box 18407- Wichita, Ks. 67218  
(Address)

SUBSCRIBED AND SWORN TO before me this 25th day of August, 19 80

Gloria DeJesus  
Gloria DeJesus Notary Public.

My commission expires 3-25-84

