


Give All Information Completely
Make Required Affidavit
Mail or Deliver Report to:
Conservation Division
State Corporation Commission
800 Bitting Building
Wichita, Kansas

WELL PLUGGING RECORD

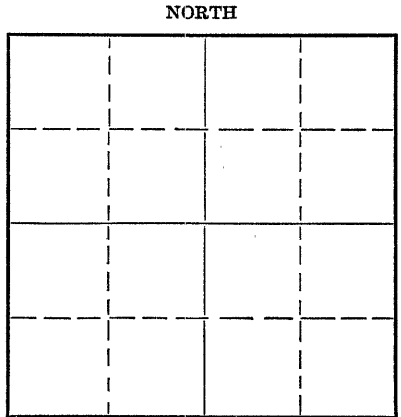

Locate well correctly on above Section Plat

Norton County. Sec. 31 Twp. 4 Rge. 23 W (W)
Location as "NE/CNW $\frac{1}{4}$ SW $\frac{1}{4}$ " or footage from lines NW NW SE
Lease Owner Empire Drilling Company and L. W. Muir
Lease Name Muir Well No. 1
Office Address 1121 Union Natl. Bank Bldg., Wichita, Kans.
Character of Well (completed as Oil, Gas or Dry Hole) Dry Hole
Date well completed 11-28-51 19
Application for plugging filed 11-28-51 19
Application for plugging approved 11-28-51 19
Plugging commenced 11-28-51 19
Plugging completed 11-28-51 19
Reason for abandonment of well or producing formation Dry Hole

If a producing well is abandoned, date of last production 19
Was permission obtained from the Conservation Division or its agents before plugging was commenced? Yes

Name of Conservation Agent who supervised plugging of this well Mr. Petty
Producing formation _____ Depth to top _____ Bottom _____ Total Depth of Well 3845' Feet
Show depth and thickness of all water, oil and gas formations.

OIL, GAS OR WATER RECORDS

CASING RECORD

Formation	Content	From	To	Size	Put In	Pulled Out
Surface		0	190'	8 5/8"	190'	0

Describe in detail the manner in which the well was plugged, indicating where the mud fluid was placed and the method or methods used in introducing it into the hole. If cement or other plugs were used, state the character of same and depth placed, from _____ feet to _____ feet for each plug set.

Plug at 175'. 1/2 sack of hulls and 15 sacks of cement. Filled hole with mud to 40 ft. Set plug 1/2 sack of hulls and 10 sacks cement to top.

RECEIVED
STATE CORPORATION COMMISSION
DEC - 4 1951
CONSERVATION DIVISION
Wichita, Kansas
12-4-51

Name of Plugging Contractor Empire Drilling Company
Address 1121 Union Natl. Bank Bldg., Wichita, Kansas

STATE OF Kansas, COUNTY OF Sedgwick, ss.
Dan J. Kornfeld (employee of owner) or (owner or operator) of the above-described well, being first duly sworn on oath, says: That I have knowledge of the facts, statements, and matters herein contained and the log of the above-described well as filed and that the same are true and correct. So help me God.
(Signature) Dan J. Kornfeld
1121 Union Natl. Bank Bldg.
(Address)

SUBSCRIBED AND SWORN TO before me this 3rd day of December, 19 51
Evelyn V. North
Notary Public.

PLUGGING
FILE SEC 31 T 4 R 23W
BOOK PAGE 629 LINE 19