

OIL & GAS CONSERVATION DIVISION

First CORRECTED

NOTICE OF INTENT TO DRILL

Form must be Typed
Form must be Signed
All blanks must be Filled

Must be approved by KCC five (5) days prior to commencing well

Note: Irregular state line section

Effective Date: 11-21-04
District # 1
SGA? Yes No

Expected Spud Date 11/20/04
month day year

Spot SW SW NE Sec. 13 Twp. 35 S. R. 16
2310 1922 feet from N / S Line of Section
2310 feet from E / W Line of Section

OPERATOR: License# 8094 8061 11/30/05
Name: Oil Producers, Inc. of Kansas
Address: P.O. Box 8647
City/State/Zip: Wichita, Ks. 67208
Contact Person: Diana Richecky
Phone: 316-681-0231

* Is SECTION Regular Irregular?
(Note: Locate well on the Section Plat on reverse side)
County: COMANCHE
Lease Name: LEON MAY Well #: 1-13

CONTRACTOR: License# 4958 5/30/05
Name: Mallard JV Inc.

* Field Name: WC
Is this a Prorated / Spaced Field? Yes No

Well Drilled For: Oil Enh Rec Infield Mud Rotary
 Gas Storage Pool Ext. Air Rotary
 OWWO Disposal Wildcat Cable
 Seismic; # of Holes Other

Target Formation(s): Mississippi Arbuckle
Nearest Lease or unit boundary: 330
Ground Surface Elevation: EST 1846' feet MSL
Water well within one-quarter mile: Yes No
Public water supply well within one mile: Yes No
Depth to bottom of fresh water: 150
Depth to bottom of usable water: 180
Surface Pipe by Alternate: 1 2
Length of Surface Pipe Planned to be set: 500
Length of Conductor Pipe required: none
Projected Total Depth: 6300
Formation at Total Depth: Arbuckle
Water Source for Drilling Operations:
 Well Farm Pond Other haul

If OWWO: old well information as follows:
Operator:
Well Name:
Original Completion Date: Original Total Depth:

Directional, Deviated or Horizontal wellbore? Yes No
If Yes, true vertical depth:
Bottom Hole Location:
KCC DKT #:

DWR Permit #: (Note: Apply for Permit with DWR)
Will Cores be taken? Yes No
If Yes, proposed zone:

* WAS: 2310' FNL, IS: 1922' FNL
* WAS: INFIELD IS: wildcat

AFFIDAVIT

RECEIVED
KANSAS CORPORATION COMMISSION
NOV 15 2004

The undersigned hereby affirms that the drilling, completion and eventual plugging of this well will comply with K.S.A. 55 et. seq.
It is agreed that the following minimum requirements will be met:

- 1. Notify the appropriate district office prior to spudding of well;
- 2. A copy of the approved notice of intent to drill shall be posted on each drilling rig;
- 3. The minimum amount of surface pipe as specified below shall be set by circulating cement to the top; in all cases surface pipe shall be set through all unconsolidated materials plus a minimum of 20 feet into the underlying formation.
- 4. If the well is dry hole, an agreement between the operator and the district office on plug length and placement is necessary prior to plugging;
- 5. The appropriate district office will be notified before well is either plugged or production casing is cemented in;
- 6. If an ALTERNATE II COMPLETION, production pipe shall be cemented from below any usable water to surface within 120 days of spud date. Or pursuant to Appendix "B" - Eastern Kansas surface casing order #133,891-C, which applies to the KCC District 3 area, alternate II cementing must be completed within 30 days of the spud date or the well shall be plugged. In all cases, NOTIFY district office prior to any cementing.

I hereby certify that the statements made herein are true and to the best of my knowledge and belief.

Date: 11/15/2004 Signature of Operator or Agent: TB. My Title: Vice President

For KCC Use ONLY
API # 15 - 033-21419-00-00
Conductor pipe required NONE feet
Minimum surface pipe required 200 feet per Alt. 1
Approved by: RJP11-16-04/RJP11-17-04
This authorization expires: 5.16.05
(This authorization void if drilling not started within 6 months of effective date.)
Spud date: Agent:

Remember to:
- File Drill Pit Application (form CDP-1) with Intent to Drill;
- File Completion Form ACO-1 within 120 days of spud date;
- File acreage attribution plat according to field proration orders;
- Notify appropriate district office 48 hours prior to workover or re-entry;
- Submit plugging report (CP-4) after plugging is completed;
- Obtain written approval before disposing or injecting salt water.
- If this permit has expired (See: authorized expiration date) please check the box below and return to the address below.
 Well Not Drilled - Permit Expired
Signature of Operator or Agent: Date:

Mail to: KCC - Conservation Division, 130 S. Market - Room 2078, Wichita, Kansas 67202

13 35 1602

IN ALL CASES PLOT THE INTENDED WELL ON THE PLAT BELOW

Plat of acreage attributable to a well in a prorated or spaced field


If the intended well is in a prorated or spaced field, please fully complete this side of the form. If the intended well is in a prorated or spaced field complete the plat below showing that the well will be properly located in relationship to other wells producing from the common source of supply. Please show all the wells and within 1 mile of the boundaries of the proposed acreage attribution unit for gas wells and within 1/2 mile of the boundaries of the proposed acreage attribution unit for oil wells.

API No. 15 - 007-21419-00-00
 Operator: Oil Producers, Inc. of Kansas
 Lease: LEON MAY
 Well Number: 1-13
 Field: _____
 Number of Acres attributable to well: _____
 QTR / QTR / QTR of acreage: SW - SW - ne


Location of Well: County: COMANCHE
2310 feet from N / S Line of Section
2310 feet from E / W Line of Section
 Sec. 13 Twp. 35 S. R. 16 East West
 Is Section: Regular or Irregular
 If Section is Irregular, locate well from nearest corner boundary.
 Section corner used: NE NW SE SW

PLAT

*(Show location of the well and shade attributable acreage for prorated or spaced wells.)
 (Show footage to the nearest lease or unit boundary line.)*

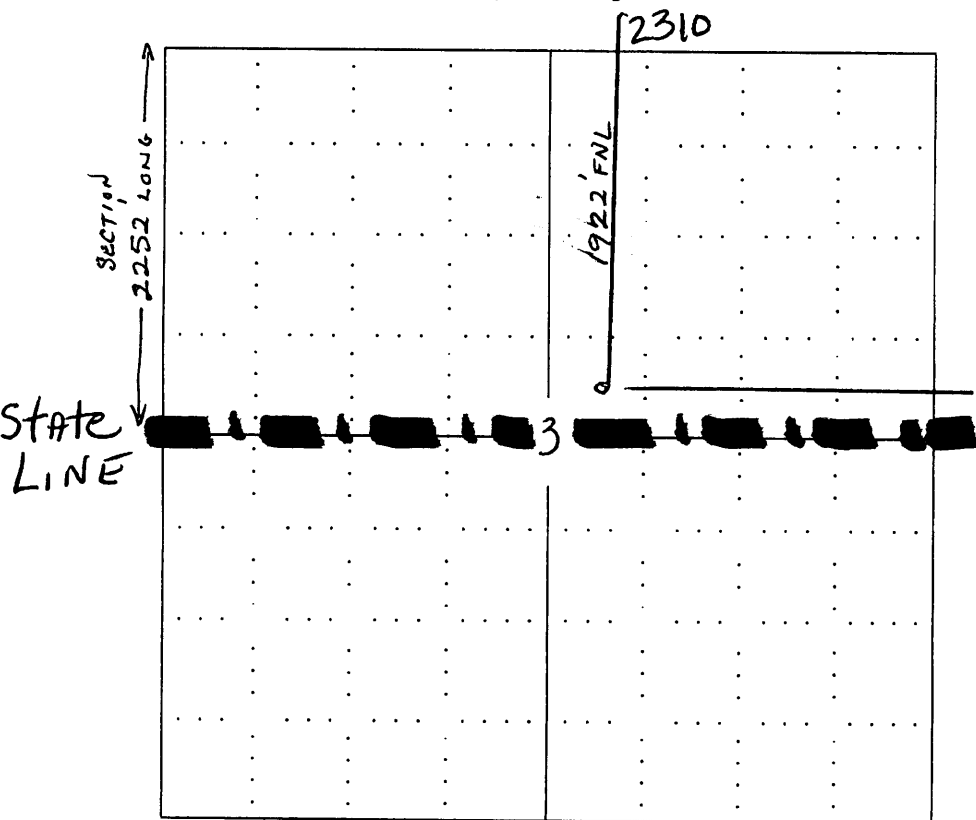

RECEIVED
 KANSAS CORPORATION COMMISSION
 NOV 15 2004
 CONSERVATION DIVISION
 WICHITA, KS

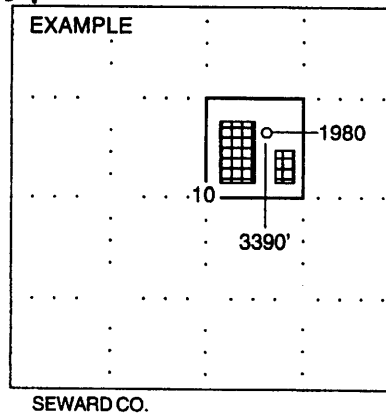

NOTE: In all cases locate the spot of the proposed drilling locaton.

In plotting the proposed location of the well, you must show:

1. The manner in which you are using the depicted plat by identifying section lines, i.e. 1 section, 1 section with 8 surrounding sections, 4 sections, etc.
2. The distance of the proposed drilling location from the section's south / north and east / west.
3. The distance to the nearest lease or unit boundary line.
4. If proposed location is located within a prorated or spaced field a certificate of acreage attribution plat must be attached: (C0-7 for oil wells; CG-8 for gas wells).