


15-137-20013-06-00

STATE OF KANSAS
STATE CORPORATION COMMISSION

WELL PLUGGING RECORD

Give All Information Completely
Make Required Affidavit
Mail or Deliver Report to:
Conservation Division
State Corporation Commission
212 No. Market
Wichita, Kansas

Norton County. Sec. 3 Twp. 4 Rge. 21 (E) (W)
Location as "NE/CNW/SW" or footage from lines G NW SW
Lease Owner National Associated Petroleum Company
Lease Name Roy Sides Well No. 1
Office Address Pawhuska, Oklahoma
Character of Well (completed as Oil, Gas or Dry Hole) dry hole
Date well completed March 6 19 68
Application for plugging filed June 27 19 68
Application for plugging approved " 28 19 68
Plugging commenced 7/5/68 19
Plugging completed 7/7/68 19
Reason for abandonment of well or producing formation ~~depleted~~ dry hole

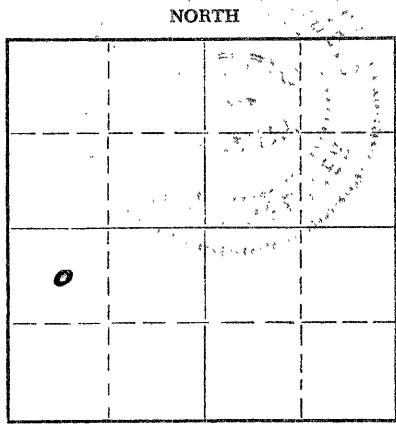

Locate well correctly on above Section Plat

If a producing well is abandoned, date of last production - 19
Was permission obtained from the Conservation Division or its agents before plugging was commenced? yes

Name of Conservation Agent who supervised plugging of this well Nichols
Producing formation _____ Depth to top _____ Bottom _____ Total Depth of Well 3567 Feet
Show depth and thickness of all water, oil and gas formations. 3769

OIL, GAS OR WATER RECORDS

CASING RECORD

FORMATION	CONTENT	FROM	TO	SIZE	PUT IN	PULLED OUT
KC	oil & water	3468	3495	8-5/8"	243'	none
				5 1/2"	3605'	1998'

Describe in detail the manner in which the well was plugged, indicating where the mud fluid was placed and the method or methods used in introducing it into the hole. If cement or other plugs were used, state the character of same and depth placed, from _____ feet to _____ feet for each plug set.

Checked hole to 3567', ran sand to 3450' and ran 5 sacks of cement. Shot pipe at 2766', 2551', 2320', 2159', 2003', worked pipe loose and pulled 61 joints. Pumped 5 hulls, 12 mud, 100 cubic ft. of cement, 13 gel and 20 cu. ft. of cement.

PLUGGING COMPLETE.

RECEIVED
STATE CORPORATION COMMISSION
JUL 12 1968
CONSERVATION DIVISION
Wichita, Kansas

17-12-68


(If additional description is necessary, use BACK of this sheet)

Name of Plugging Contractor KNIGHT CASING PULLING CO., INC.
Address CHASE, KANSAS

STATE OF KANSAS, COUNTY OF RICE, ss.
NOEL J. KNIGHT

(employee of owner) or (owner or operator) of the above-described well, being first duly sworn on oath, says: That I have knowledge of the facts, statements, and matters herein contained and the log of the above-described well as filed and that the same are true and correct. So help me God.

(Signature) [Signature]
CHASE, KANSAS
(Address)

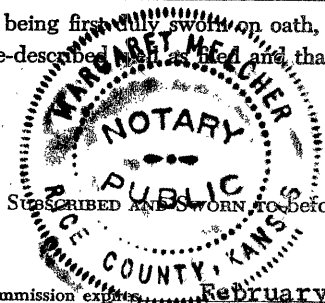

Subscribed and sworn to before me this 9th day of July, 1968

My commission expires February 15, 1971

[Signature]
Notary Public.