


STATE OF KANSAS  
STATE CORPORATION COMMISSION

Give All Information Completely  
Make Required Affidavit  
Mail or Deliver Report to:  
Conservation Division  
State Corporation Commission  
800 Bittling Building  
Wichita, Kansas

15-137-00186-00-00  
WELL PLUGGING RECORD

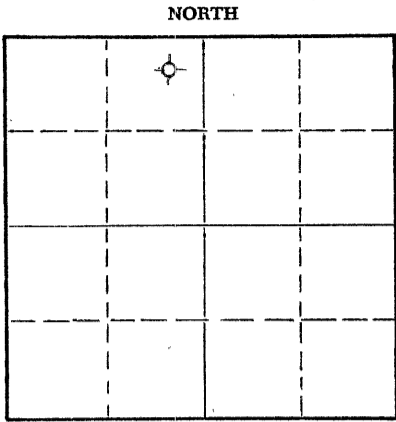

Locate well correctly on above  
Section Plat

Norton County. Sec. 32 Twp. 4S Rge. 21 (E) W (W)  
Location as "NE/CNW%SW%" or footage from lines NE NE NW  
Lease Owner D. G. Hansen  
Lease Name Tibets Well No. 1  
Office Address Logan, Kansas  
Character of Well (completed as Oil, Gas or Dry Hole) Dry Hole  
Date well completed October 11 19 55  
Application for plugging filed October 11 19 55  
Application for plugging approved October 11 19 55  
Plugging commenced October 12 19 55  
Plugging completed October 12 19 55  
Reason for abandonment of well or producing formation Too low structually

If a producing well is abandoned, date of last production 19  
Was permission obtained from the Conservation Division or its agents before plugging was commenced? Yes

Name of Conservation Agent who supervised plugging of this well Eldon Petty, Hays, Kansas  
Producing formation \_\_\_\_\_ Depth to top \_\_\_\_\_ Bottom \_\_\_\_\_ Total Depth of Well 3745 Feet  
Show depth and thickness of all water, oil and gas formations.

OIL, GAS OR WATER RECORDS

CASING RECORD

FORMATION	CONTENT	FROM	TO	SIZE	PUT IN	PULLED OUT
				8-5/8	208'	none

Describe in detail the manner in which the well was plugged, indicating where the mud fluid was placed and the method or methods used in introducing it into the hole. If cement or other plugs were used, state the character of same and depth placed, from \_\_\_\_\_ feet to \_\_\_\_\_ feet for each plug set.

Filled hole with heavy mud to 200'  
Set plug. Put in 1/2 sack Hulls and 15 sacks of cement. Filled with heavy mud up to 40'. Set plug.  
Filled to top with 1/2 sack hulls and 10 sacks cement.

RECEIVED  
STATE CORPORATION COMMISSION  
OCT 13 1955  
CONSERVATION DIVISION  
WICHITA, KANSAS

(If additional description is necessary, use BACK of this sheet)  
Name of Plugging Contractor C- G Drilling Co. 10-18-55  
Address 107 Rule Bldg., Wichita, Kansas


STATE OF Kansas, COUNTY OF Sedgwick, ss.  
Jay H. Galloway (employee of owner) or (owner or operator) of the above-described well, being first duly sworn on oath, says: That I have knowledge of the facts, statements, and matters herein contained and the log of the above-described well as filed and that the same are true and correct. So help me God.

(Signature) Jay H. Galloway  
107 Rule Building  
(Address)

SUBSCRIBED AND SWORN to before me this 17th day of October, 1955

My commission expires May 20, 1959

Vicky Jacobs  
Notary Public.

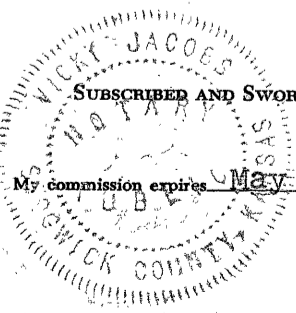

PLUGGING  
PLX SEC 32 T 4 R 21 W  
BOOK PAGE 9 LINE 15

15-137-00186-06-00

CONTRACTOR'S WELL LOG

OPERATOR D. G. HANSEN WELL NAME TIBETS #1

WELL LOCATION NE NE NW Sec 32-4S-21W RIG #1

COUNTY NORTON STATE KANSAS

COMMENCEMENT DATE OCTOBER 3, 1955 COMPLETION DATE OCTOBER 12, 1955

LOG OF WELL

Elevation 2130 rotary bushing.  
All measurements from the top of rotary bushing.

FROM	TO	FORMATION	DEVIATION FROM VERTICAL	REMARKS
0	208	Shale		
208	750	Shale		
750	930	Shale		
930	1030	Sand		
1030	1290	Sandy Shale		
1290	1510	Sand		
1510	1700	RedBed		
1700	1767	Shale		
1767	1805	Anhydrite		
1805	1985	Shale-Shells		
1985	2185	Lime-Shale		
2185	2385	Lime-Shale		
2385	2510	Lime-Shale	0° - 2500'	
2510	2660	Lime-Shale		
2660	2775	Lime-Shale	0° - 2750'	
2775	2900	Lime-Shale		
2900	3015	Lime-Shale	0° - 3000'	
3015	3095	Lime-Shale		
3095	3170	Lime-Shale		
3170	3245	Lime-Shale		
3245	3315	Lime-Shale	0° - 3250'	
3315	3355	Lime-Shale		
3355	3405	Lime-Shale		
3405	3448	Lime-Shale		
3448	3500	Lime-Shale	0° - 3500'	DST 3491-3512'
3500	3512	Lime-Shale		
3512	3565	Lime-Shale		
3565	3592	Lime-Shale		
3592	3645	Lime-Shale		

CASING LEFT IN HOLE AFTER COMPLETION

207.92' of 8-5/8" OD Surface Casing  
STATE OF KANSAS, COUNTY OF SEDGWICK ) ss.

The undersigned certifies that to the best of his knowledge and belief, the above facts are true and correct.

C-G DRILLING CO.

By Jay H. Galloway  
Jay H. Galloway

Subscribed and sworn to before me this 17th day of October, 1955.

Vicky Jacobs  
Vicky Jacobs, Notary Public

My commission expires:  
May 20, 1959

PLUGGING  
WELL SEC 32 T 4 R 21W  
BOOK PAGE 9 LINE 15

10-18-55