

15-137-20225-00-00

STATE OF KANSAS
STATE CORPORATION COMMISSION

WELL PLUGGING RECORD

Give All Information Completely
Make Required Affidavit
Mail or Deliver Report to
Conservation Division
State Corporation Comm.
245 North Water
Wichita, KS 67202

Norton County. Sec. 26 Twp. 4S Rge. 21W E/W
Location as "NE/CNW $\frac{1}{4}$ SW $\frac{1}{4}$ " or footage from lines
C N $\frac{1}{2}$ NE $\frac{1}{4}$

Lease Owner Ozark Enterprises
Lease Name Lutz- Wiltrout Well No. 1
Office Address Logan, Kansas 67646

Character of Well (Completed as Oil, Gas or Dry Hole)
Dry Hole


Date Well completed March 27 1981
Application for plugging filed March 27 1981
Application for plugging approved March 27 1981
Plugging commenced March 27 1981
Plugging completed March 27 1981
Reason for abandonment of well or producing formation
Dry Hole

If a producing well is abandoned, date of last production
19

Was permission obtained from the Conservation Division or
its agents before plugging was commenced? Yes

Name of Conservation Agent who supervised plugging of this well Gilbert Balthazor
Producing formation Depth to top Bottom Total Depth of Well 3635'

Show depth and thickness of all water, oil and gas formations.

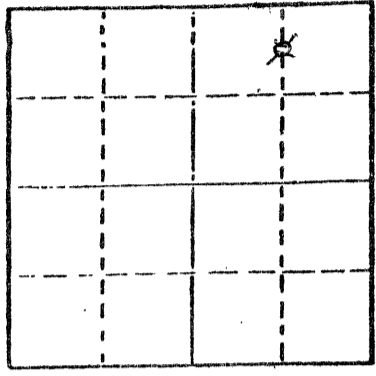

Locate well correctly on above
Section Plot

OIL, GAS OR WATER RECORDS

CASING RECORD

FORMATION	CONTENT	FROM	TO	SIZE	PUT IN	PULLED OUT
Surface		0	210'	85/8"	210	0

Describe in detail the manner in which the well was plugged, indicating where the mud fluid
was placed and the method or methods used in introducing it into the hold. If cement or other
plugs were used, state the character of same and depth placed, from feet to
feet for each plug set.

- 1st Plug set at 840' with 60 sacks cement 50-50 poz 6%gel
- 2nd Plug set at 230' with 30 sacks cement 50-50 poz 6%gel
- 3rd Plug set at 40' with 10 sacks cement 50-50 poz 6%gel
- 5 sacks cement in rathole

(If additional description is necessary, use BACK of this sheet)

Name of Plugging Contractor Allied Cementing Co. Inc.

RECEIVED
STATE CORPORATION COMMISSION

STATE OF Kansas COUNTY OF Graham
Jerry M. Helberg (employee of owner) or (owner or operator)


of the above-described well, being first duly sworn on oath, says: That I have knowledge of
the facts, statements, and matters herein contained and the log of the above-described well
as filed and that the same are true and correct. So help me God.

(Signature) Jerry M. Helberg
Box 32 Morland, Kansas 67650
(Address)

SUBSCRIBED AND SWORN TO before me this 15 day of April, 1981

Janice Robinson
Notary Public.

My commission expires Dec. 4, 1983

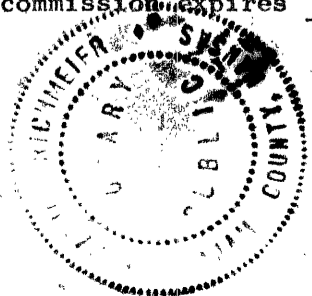

15-137-20225-00-00

DRILLERS LOG

LUTZ-WILTROUT #1

CASING RECORD:

8 5/8" set at 210'

TOTAL DEPTH:

3636'

DESCRIPTION:

C N 1/2 NE 1/4
26 4S 21 W Norton County, Kansas

OPERATOR: Ozark Enterprises

CONTRACTOR: Helberg Oil Company

COMMENCED: March 19, 1981

COMPLETED: March 28, 1981

FORMATION	FROM	TO	REMARKS
Sand	0	80	
Sand	80	220	
Shale	220	638	
Shale & Sand	638	1004	
Shale & Sand	1004	1607	
Shale	1607	1743	
Andhydrite	1743	1774	
Shale	1774	1787	
Shale	1787	2160	
Shale & Lime	2160	2325	
Shale & Lime	2325	2444	
Shale	2444	2590	
Shale & Lime	2590	2715	
Shale & Lime	2715	2817	
Shale & Lime	2817	2931	
Shale & Lime	2931	3025	
Shale & Lime	3025	3102	
Shale & Lime	3102	3192	
Shale & Lime	3192	3280	
Lime	3280	3359	
Lime	3359	3439	
Lime	4339	3486	
Lime	3486	3505	
Lime	3505	3560	
Lime	3560	3620	
Lime	3620	3635	
T.D.	3635		D&A

I certify that the above is a true and correct copy of the log to the best of my knowledge.

Helberg Oil Company

Jerry M. Helberg
Jerry M. Helberg

Subscribed and sworn to before me this 15 day of April, 1981.

Janice Robinson
Notary Public

My commission expires December 4, 1983

RECEIVED
STATE CORPORATION COMMISSION

APR 16 1981

COUNTY OF WICHITA, KANSAS

4-16-81

