

15-137-20094-00-00


STATE OF KANSAS
STATE CORPORATION COMMISSION

Form CP-4

Give All Information Completely
Make Required Affidavit
Mail or Deliver Report to:
Conservation Division
State Corporation Commission

P. O. Box 17027
Wichita, Kansas 67217
NORTH

WELL PLUGGING RECORD

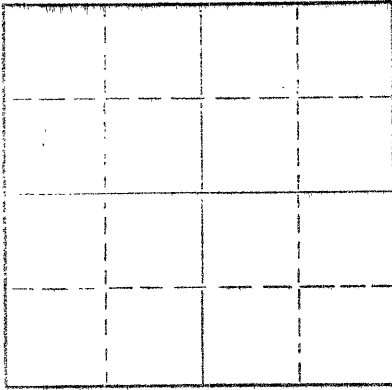

Locate well correctly on above
Section Plat

Norton County, Sec. 10 Twp. 4S Rge. 21W (E) (W)
Location as "NE/CNW/SW" or footage from lines NW SW NE
Lease Owner Bell Brothers
Lease Name Van Loenen Well No. 1
Office Address 201 N. Jefferson, Robinson, Illinois 62454
Character of Well (completed as Oil, Gas or Dry Hole) D & A
Date well completed July 1 19 74
Application for plugging filed July 1 19 74
Application for plugging approved July 1 19 74
Plugging commenced July 1 19 74
Plugging completed July 1 19 74
Reason for abandonment of well or producing formation D & A

If a producing well is abandoned, date of last production 19
Was permission obtained from the Conservation Division or its agents before plugging was commenced? Yes

Name of Conservation Agent who supervised plugging of this well Mr. W.L. Nichols
Producing formation _____ Depth to top _____ Bottom _____ Total Depth of Well 3770 Feet
Show depth and thickness of all water, oil and gas formations.

OIL, GAS OR WATER RECORDS

CASING RECORD

FORMATION	CONTENT	FROM	TO	SIZE	PUT IN	PULLED OUT
				8-5/8"	223'	-0-

Describe in detail the manner in which the well was plugged, indicating where the mud fluid was placed and the method or methods used in introducing it into the hole. If cement or other plugs were used, state the character of same and depth placed, from _____ feet to _____ feet for each plug set.


Plug #1 - 900' w/70 sx.
Plug #2 - 215' w/20 sx.
Plug #3 - 40' w/10 sx.
Total 100 sx. 50-50 pozmix, 6% gel.

RECEIVED
STATE CORPORATION COMMISSION
JUL 15 1974
CONSERVATION DIVISION
Wichita, Kansas
7-15-74

(If additional description is necessary, use BACK of this sheet)
Name of Plugging Contractor Red Tiger Drilling Company
Address 1720 Wichita Plaza, Wichita, Kansas 67202

STATE OF Kansas COUNTY OF Sedgwick, ss.
Linda H. Dickens (employee of owner) or (owner or operator) of the above-described

well, being first duly sworn on oath, says: That I have knowledge of the facts, statements, and matters herein contained and the log of the above-described well as filed and that the same are true and correct. So help me God.

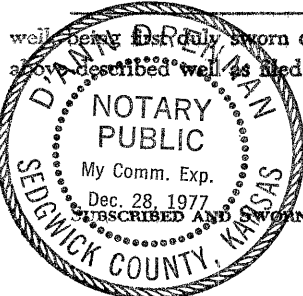

(Signature) Linda H. Dickens
1720 Wichita Plaza, Wichita, Kansas 67202
(Address)

SUBSCRIBED AND SWORN to before me this 9th day of July, 19 74

My commission expires December 28, 1977 Notary Public.

15-137-20094-00-00

DRILLERS LOG

No. 1 Van Loenen

CASING RECORD:

8-5/8" @ 223'
w/150 sx cmt

TOTAL DEPTH: 3770'

COMPANY: Bell Brothers

CONTRACTOR: Red Tiger Drilling Co.

COMMENCED: June 24, 1974

COMPLETED: July 1, 1974

DESCRIPTION:

NW SW NE
10-4S-21W
Norton County,
Kansas

ELEVATION: 2194' Gr.

<u>FORMATION</u>	<u>FROM</u>	<u>TO</u>	<u>REMARKS</u>
Surface Hole	0	240	
Clay, Shale & Shells	240	1102	
Sand	1102	1152	
Shale	1152	1288	
Hard Sand	1288	1292	
Shale & Sand	1292	1350	
Sand	1350	1530	
Hard Shale	1530	1570	
Shale & Sand	1570	1875	
Anhydrite	1875	1905	
Shale & Shells	1905	2225	
Shale & Lime	2225	2805	
Lime	2805	3770	

RECEIVED
STATE CORPORATION COMMISSION
JUL 15 1974
CONSERVATION DIVISION
Wichita, Kansas
7-15-74

I certify that this is a true and correct copy of the above log to the best of my knowledge.

RED TIGER DRILLING COMPANY

Linda H. Dickens
Linda H. Dickens

Subscribed and sworn to before me this 9th day of July, 1974.

D'Ann Drennan
Notary Public

My Commission Expires:

December 28, 1977

