

15-137-20172-00-00

STATE OF KANSAS
STATE CORPORATION COMMISSION

WELL PLUGGING RECORD


Give All Information Completely
Make Required Affidavit
Mail or Deliver Report to
Conservation Division
State Corporation Comm.
245 North Water
Wichita, KS 67202

Norton County, Sec. 14 Twp. 4S Rge. 21W E/W
Location as "NE/CNW $\frac{1}{2}$ /SW $\frac{1}{2}$ " or footage from lines
NE NE NE

Lease Owner Baird Oil Company
Lease Name Adee Well No. #1

Office Address Box 7, Logan County, Ks.

Character of Well (Completed as Oil, Gas or Dry Hole)
Dry Hole

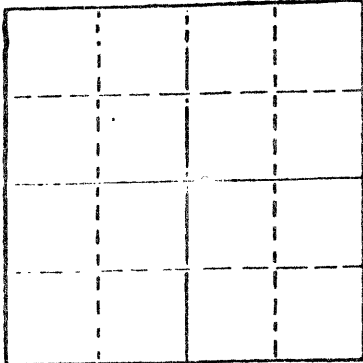

Locate well correctly on above
Section Plat

Date Well completed May 28 1980
Application for plugging filed May 28 1980
Application for plugging approved May 28 1980
Plugging commenced May 28 1980
Plugging completed May 28 1980

Reason for abandonment of well or producing formation
No commercial quantity of oil or gas encountered.
If a producing well is abandoned, date of last production
19

Was permission obtained from the Conservation Division or
its agents before plugging was commenced? Yes

Name of Conservation Agent who supervised plugging of this well Marion Schmidt
Producing formation _____ Depth to top _____ Bottom _____ Total Depth of Well 3640'
Show depth and thickness of all water, oil and gas formations.

OIL, GAS OR WATER RECORDS

CASING RECORD

FORMATION	CONTENT	FROM	TO	SIZE	PUT IN	PULLED OUT

Describe in detail the manner in which the well was plugged, indicating where the mud fluid
was placed and the method or methods used in introducing it into the hold. If cement or other
plugs were used, state the character of same and depth placed, from _____ feet to
_____ feet for each plug set.

T.D. 3640'

Set 1st plug at 840' with 60 sacks

2nd plug at 240' with 30 sacks

3rd plug at 40' solid birdge with 10 sacks

5 sacks in the rathole

Cemented with 50/50 posmix, 6% gel.

Plug was down at 4:15 p.m., 5-28-80

RECEIVED
STATE CORPORATION COMMISSION

JUN 16 1980

CONSERVATION DIVISION
Wichita, Kansas

6-16-80

(If additional description is necessary, use BACK of this sheet)

Name of Plugging Contractor Abercrombie Drilling, Inc.

STATE OF Kansas COUNTY OF Sedgwick, ss.
Jack L. Partridge, Asst. Sec-Treasurer (employee of owner) or (owner or operator)
of the above-described well, being first duly sworn on oath, says: That I have knowledge of
the facts, statements, and matters herein contained and the log of the above-described well
as filed and that the same are true and correct. So help me God.

(Signature)

801 Union Center, Wichita, Ks.

(Address)

SUBSCRIBED AND SWORN TO before me this 12th day of June, 1980



Sherrie L. Brooks

Notary Public.

My commission expires 8-21-82

CONTRACTOR'S WELL LOG

Operator: Baird Oil Company
 Contractor: Abercrombie Drilling, Inc.
 Well Name: Adee #1
 Location: NE NE NE
 Section 14-4S-21W
 Norton County, Kansas
 Spud Date: May 19, 1980
 Completion Date: May 28, 1980

0	253	Shale and Sand
253	1770	Sand and shale
1770	1800	Anhydrite
1800	3640	Shale and Lime
	3640	Rotary Total Depth

Spud hole at 4:45 p.m., May 19, 1980. Drilled 253' of 12-1/4" hole. Ran 6 joints of 8-5/8" 20# casing. (Tally 242.68) Pipe set at 249.18'. Cemented with 200 sacks of common, 2% gel, 3% Ca.Cl. Plug was down at 10:45 p.m., 5-19-80.

T.D. 3640'. Set 1st plug at 840' with 60 sacks, 2,d plug at 240' with 30 sacks, 3rd plug 40' solid bridge with 10 sacks, and rathole with 5 sacks. 50/50 posmix, 6% gel, . Plug was down at 4:15 p.m., 5-28-80

SAMPLE TOPS:
 Anhydrite 1771'
 B/Anhydrite 1801'

RECEIVED

STATE OF KANSAS)
) ss
 COUNTY OF SEDGWICK)

Jack L. Partridge, Assistant Secretary-Treasurer of Abercrombie Drilling, Inc., does hereby state that the above and foregoing is a true and correct copy of the log of the Adee #1, NE NE NE, Section 14-4S-21W, Norton County, Kansas.

Abercrombie Drilling, Inc.
 By: Jack L. Partridge
 Jack L. Partridge
 Assistant Secretary-Treasurer

Subscribed and sworn to before me, a Notary Public, in and for the county and sate aforesaid, as of this 12th day of June, 1980.

My commission expires 8-21-82

Sherrie L. Brooks
 Sherrie L. Brooks, Notary Public

