


Give All Information Completely
Make Required Affidavit
Mail or Deliver Report to:
Conservation Division
State Corporation Commission
212 No. Market
Wichita, Kansas

WELL PLUGGING RECORD

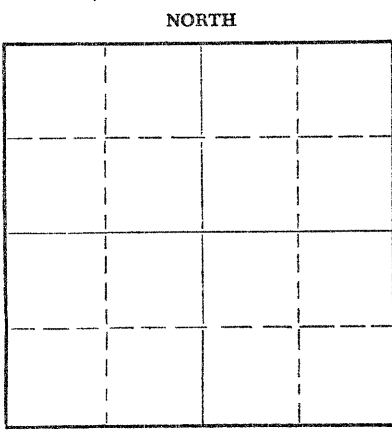

Locate well correctly on above Section Plat

Norton County. Sec. 4 Twp. 35 Rge. (E) 21(W)
Location as "NE/CNW&SW¼" or footage from lines NW NW SW
Lease Owner National Associated Petroleum Company
Lease Name Martha M. Schick Well No. 1
Office Address Petroleum Building - Tulsa, Oklahoma
Character of Well (completed as Oil, Gas or Dry Hole) Dry Hole
Date well completed March 4 1969
Application for plugging filed March 4 1969
Application for plugging approved _____ 19____
Plugging commenced March 4 1969
Plugging completed March 4 1969
Reason for abandonment of well or producing formation D&A

If a producing well is abandoned, date of last production _____ 19____
Was permission obtained from the Conservation Division or its agents before plugging was commenced? _____

Name of Conservation Agent who supervised plugging of this well _____
Producing formation _____ Depth to top _____ Bottom _____ Total Depth of Well _____ Feet
Show depth and thickness of all water, oil and gas formations.

OIL, GAS OR WATER RECORDS

CASING RECORD

FORMATION	CONTENT	FROM	TO	SIZE	PUT IN	PULLED OUT
				8 5/8	200'	-0-

Describe in detail the manner in which the well was plugged, indicating where the mud fluid was placed and the method or methods used in introducing it into the hole. If cement or other plugs were used, state the character of same and depth placed, from _____ feet to _____ feet for each plug set.

Mud to 1125'
60 sacks posmix 6% gel.
Mud to 240'
30 sacks posmix 6% gel
mud to 40'
10 sacks posmix 6% gel
mud to surface

RECEIVED
STATE CORPORATION COMMISSION
MAR 14 1969
CONSERVATION DIVISION
Wichita, Kansas

3-14-69

(If additional description is necessary, use BACK of this sheet)

Name of Plugging Contractor _____
Address _____

STATE OF Oklahoma, COUNTY OF Tusla, ss.
Jack Roberts (employee of owner) or (owner or operator) of the above-described well, being first duly sworn on oath, says: That I have knowledge of the facts, statements, and matters herein contained and the log of the above-described well as filed and that the same are true and correct. So help me God.

(Signature) Jack Roberts
(Address) _____

SUBSCRIBED AND SWORN TO before me this 13th day of March, 1969

My commission expires Dec. 15, 1972
Sara L. Marsh
Notary Public.

15-137-20022-00-00



Broken Arrow Drilling Company

ROOM 409 PETROLEUM BUILDING • TULSA, OKLAHOMA 74103 • AC 918-582-1181

DRILLER'S LOG

COMPANY: NAT'L ASSOC. PET'L CO.
PETROLEUM BUILDING
TULSA, OKLAHOMA 74103
FARM: MARTHA M. SCHICK NO.1

TOTAL DEPTH 3802

COMM.: 2/19/69 **COMP.:** 3/4/69

CONTRACTOR: BROKEN ARROW DRILLING COMPANY
PETROLEUM BUILDING
TULSA, OKLAHOMA 74103

SEC. 4 **TWP.** 4S **RGE.** 21W

LOCATION: NW NW S

COUNTY: NORTON CO.

ELEVATION

PRODUCTION:

CASING RECORD: 8 5/8" 200'

CEMENT RECORD: 125 sks cement
200# A.C., 200# C. C.

0-206	SOIL
206-861	SHALE
861-1200	SHALE & SAND
1200-2240	SHALE
2240-3278	SHALE & LIME
3278-3305	LIME
3305-3332	SHALE & LIME
3332-3802	LIME
T. D.	

RECEIVED
STATE CORPORATION COMMISSION
MAR 14 1969
CONSERVATION DIVISION
Wichita, Kansas

3-14-69

We hereby certify that the above is a true copy of the Driller's Log for the above described well.

BROKEN ARROW DRILLING COMPANY

By:

Jack Roberts

Jack Roberts

Subscribed and sworn to before me this 13th day of March, 1969

My Commission expires:

Dec. 15, 1972

Sara L. Marsh

Notary Public