


WELL PLUGGING RECORD

Give All Information Completely
Make Required Affidavit
Mail or Deliver Report to:
Conservation Division
State Corporation Commission
212 No. Market
Wichita, Kansas

Decatur County, Sec. 14 Twp. 4S Rge. 27 (W)
Location as "NE/CNW/SW" or footage from lines Ctr SW SE
Lease Owner Champlin Petroleum Company
Lease Name Shimmick Well No. 1
Office Address P. O. Box 308, Ellinwood, Kansas
Character of Well (completed as Oil, Gas or Dry Hole) Dry Hole
Date well completed August 17 19 69
Application for plugging filed August 16 (verbal) 19 69
Application for plugging approved August 16 19 69
Plugging commenced August 17 19 69
Plugging completed August 17 19 69
Reason for abandonment of well or producing formation

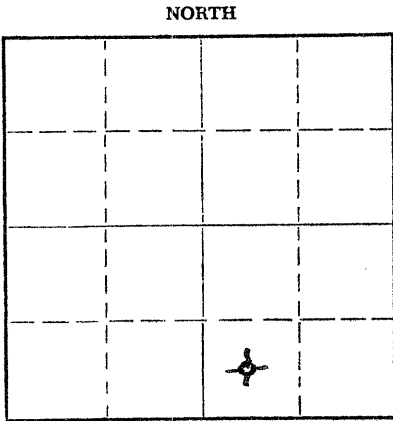

Locate well correctly on above Section Plat

If a producing well is abandoned, date of last production 19
Was permission obtained from the Conservation Division or its agents before plugging was commenced? Yes

Name of Conservation Agent who supervised plugging of this well W. L. Nichols - Leo F. Massey
Producing formation Depth to top Bottom Total Depth of Well 3725 Feet
Show depth and thickness of all water, oil and gas formations.

OIL, GAS OR WATER RECORDS				CASING RECORD		
FORMATION	CONTENT	FROM	TO	SIZE	PUT IN	PULLED OUT
				8 5/8" OD	250'	None

Describe in detail the manner in which the well was plugged, indicating where the mud fluid was placed and the method or methods used in introducing it into the hole. If cement or other plugs were used, state the character of same and depth placed, from feet to feet for each plug set.
Filled hole with mud to 1300' and pumped in 100 sacks of cement then mud to 270' and pumped in 20 sacks of cement then mud to 40' and pushed plug and 1/2 sack of hulls to form a bridge at 40' and pumped in 10 sacks of cement to fill hole to bottom of cellar. Job completed at 7:15 p.m. 8/17/69.
All cement was 50/50 Pozmix with 6% added gel.

RECEIVED
STATE CORPORATION COMMISSION
AUG 20 1969
CONSERVATION DIVISION
Wichita, Kansas

8-20-69

(If additional description is necessary, use BACK of this sheet)
Name of Plugging Contractor Leben Drilling, Inc.
Address 200 Sutton Place, Wichita, Kansas

STATE OF Kansas, COUNTY OF Barton, ss.
J. W. Meyers (employee of owner) or (owner or operator) of the above-described well, being first duly sworn on oath, says: That I have knowledge of the facts, statements, and matters herein contained and the log of the above-described well as filed and that the same are true and correct. So help me God.

(Signature) J. W. Meyers, District Operations Manager
P. O. Box 308, Ellinwood, Kansas
(Address)

SUBSCRIBED AND SWORN to before me this 19th day of August, 19 69

My commission expires 5/22/70

N. Kenneth Stivers
Notary Public.

DRILLER'S LOG

COMPANY	CHAMPLIN PETROLEUM CO.
CONTRACTOR	LEBEN DRILLING, INC.
FARM	SHIMMICK #1
LOCATION	G SW SE Section 14-4S-27W
	DECATUR COUNTY, KANSAS
COMMENCED	8-7-69
COMPLETED	8-18-69

0	100
100	248
248	921
921	1559
1559	1802
1802	1807
1807	2118
2118	2149
2149	2365
2365	2853
2853	3345
3345	3427
3427	3526
3526	3540
3540	3592
3592	3657
3657	3682
3682	3725
	<u>3725</u>

Sand
 Blue Shale
 Shale
 Shale, Sand
 Sand, Shale
 Anhydrite
 Shale
 Anhydrite
 Shale
 Shale, Lime
 Lime, Shale
 Lime
 Lime Shale
 Lime
 Lime, Shale
 Lime
 Shale, Lime
 Lime
TD

RECEIVED
 STATE CORPORATION COMMISSION
 AUG 28 1969
 CONSERVATION DIVISION
 Wichita, Kansas
 8-28-69

8 5/8" 20# new casing set @ 248' with 175 sacks Common Sunset Cement.

I, Leslie Kite, do hereby certify that the above and foregoing is a true and correct copy of the log of the Shimmick #1 Well, located G SW SE of Section 14, Township 4 South, Range 27 West, Decatur County, Kansas, as reflected by the records of Leben Drilling, Inc.

Leslie Kite
 Leslie Kite

STATE OF KANSAS)
) SS
 COUNTY OF BARTON)

Subscribed and sworn to and before me, A Notary Public, in and for Barton County, Kansas, this 26th day of August, 1969.

Ulanda Nichols
 Ulanda Nichols

