

15-039-20280-00-00

STATE OF KANSAS  
STATE CORPORATION COMMISSION

Form CP-4


Give All Information Completely  
Make Required Affidavit  
Mail or Deliver Report to:  
Conservation Division  
State Corporation Commission

WELL PLUGGING RECORD

P. O. Box 17027  
Wichita, Kansas 67217  
NORTH

Decatur County, Sec. 14 Twp. 4S Rge. (E) 27 (W)

Location as "NE/CNW/SW" or footage from lines NE NE SW  
Lease Owner K.R.M. Petroleum Corporation  
Lease Name SHIMMICK Well No. 1  
Office Address Guaranty Bank Bldg., 817 Seventeenth, Denver, Colorado  
Character of Well (completed as Oil, Gas or Dry Hole) Dry Hole 80202  
Date well completed February 16, 19 74  
Application for plugging filed (verbally) February 16, 19 74  
Application for plugging approved (verbally) February 16, 19 74  
Plugging commenced February 16, 19 74  
Plugging completed February 16, 19 74  
Reason for abandonment of well or producing formation Dry Hole

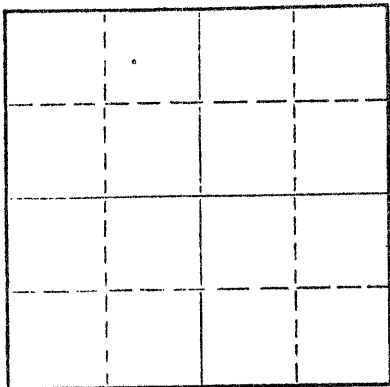

Locate well correctly on above  
Section Plat

If a producing well is abandoned, date of last production 19  
Was permission obtained from the Conservation Division or its agents before plugging was commenced? Yes

Name of Conservation Agent who supervised plugging of this well Bill Nichols  
Producing formation \_\_\_\_\_ Depth to top \_\_\_\_\_ Bottom \_\_\_\_\_ Total Depth of Well 3729 Feet  
Show depth and thickness of all water, oil and gas formations.

OIL, GAS OR WATER RECORDS

CASING RECORD

FORMATION	CONTENT	FROM	TO	SIZE	PUT IN	PULLED OUT

Describe in detail the manner in which the well was plugged, indicating where the mud fluid was placed and the method or methods used in introducing it into the hole. If cement or other plugs were used, state the character of same and depth placed, from \_\_\_\_\_ feet to \_\_\_\_\_ feet for each plug set.

1st plug set at 1350' w/110 cu. ft. cement  
2nd plug set at 275' w/30 cu. ft. cement  
3rd plug set at 40' w/10 cu. ft. cement  
Job completed at 12:00 noon 2-16-74

RECEIVED  
STATE CORPORATION COMMISSION  
FEB 21 1974  
CONSERVATION DIVISION  
Wichita, Kansas  
2-21-74

(If additional description is necessary, use BACK of this sheet)  
Name of Plugging Contractor Abercrombie Drilling, Inc.  
Address 801 Union Center, Wichita, Kansas 67202

STATE OF KANSAS, COUNTY OF SEDGWICK, ss.  
Jerry A. Langrehr (employee of owner) or (owner or operator) of the above-described well, being first duly sworn on oath, says: That I have knowledge of the facts, statements, and matters herein contained and the log of the above-described well as filed and that the same are true and correct. So help me God.

(Signature) Jerry A. Langrehr  
801 Union Center, Wichita, Kansas 67202  
(Address)

SUBSCRIBED AND SWORN TO before me this 19th day of February, 19 74

My commission expires February 10, 1975

Beverly Mann  
Beverly Mann  
Notary Public.