

WELL PLUGGING RECORD

Give All Information Completely
Make Required Affidavit
Mail or Deliver Report to:
Conservation Division
State Corporation Commission
211 No. Broadway
Wichita, Kansas

Decatur

County. Sec. 11 Twp. 4S Rge. 27W (E) (W)

Location as "NE/CNW/SW" or footage from lines NW N NW

Lease Owner National Associated Petroleum Co.

Lease Name Joseph Petracek Well No. 1

Office Address Fifth Floor Ritz Bldg., Tulsa, Okla.

Character of Well (completed as Oil, Gas or Dry Hole) Dry Hole

Date well completed 8-7-65 19

Application for plugging filed 8-7-65 19

Application for plugging approved 8-7-65 19


Plugging commenced 8-7-65 19

Plugging completed 8-7-65 19

Reason for abandonment of well or producing formation

If a producing well is abandoned, date of last production 19

Was permission obtained from the Conservation Division or its agents before plugging was commenced?

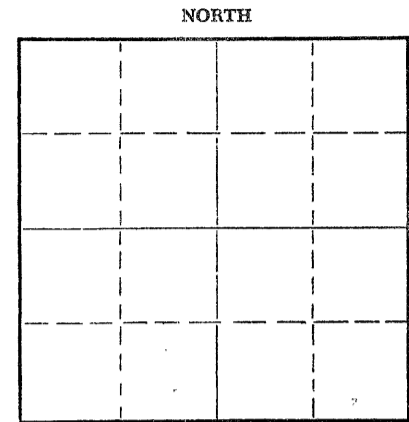

Locate well correctly on above Section Plat

Name of Conservation Agent who supervised plugging of this well Bill Nichols

Producing formation Depth to top Bottom Total Depth of Well 3810 Feet

Show depth and thickness of all water, oil and gas formations.

OIL, GAS OR WATER RECORDS

CASING RECORD

FORMATION	CONTENT	FROM	TO	SIZE	PUT IN	PULLED OUT
Surface casing		surface	247'	8-5/8"		0

Describe in detail the manner in which the well was plugged, indicating where the mud fluid was placed and the method or methods used in introducing it into the hole. If cement or other plugs were used, state the character of same and depth placed, from feet to feet for each plug set.

First plug - 600' with 20 sacks
Second plug - 240' with 20 sacks
Top plug - 10 sacks

RECEIVED
STATE CORPORATION COMMISSION

AUG 19 1965

CONSERVATION DIVISION
Wichita, Kansas

8-19-65

(If additional description is necessary, use BACK of this sheet)

Name of Plugging Contractor Burch Exploration, Inc.

Address 1011 Union Center, Wichita, Kansas

STATE OF KANSAS, COUNTY OF SEDGWICK of Burch Exploration, Inc.
Earl M. Burch (employee of owner) or (owner or operator) of the above-described

well, being first duly sworn on oath, says: That I have knowledge of the facts, statements, and matters herein contained and the log of the above-described well as filed and that the same are true and correct. So help me God.

(Signature) Earl M. Burch

1011 Union Center, Wichita, Kansas (Address)

SUBSCRIBED AND SWORN TO before me this 18th day of August, 19 65

Minnie E. Matson

My commission expires June 18, 1968

Notary Public.