


15-039-00027-00-00

WELL PLUGGING RECORD

Give All Information Completely
Make Required Affidavit
Mail or Deliver Report to:
Conservation Division
State Corporation Commission
800 Bitting Building
Wichita, Kansas

NORTH

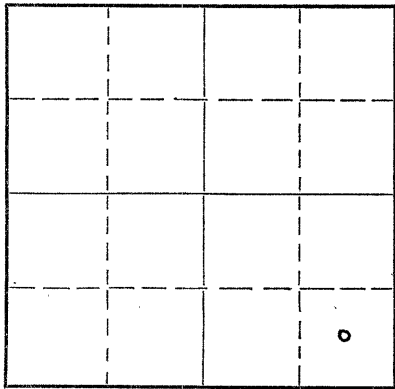

Locate well correctly on above
Section Plat

Decatur County, Sec. 4 Twp. 4S Rge. 27 ~~28~~ (W)
Location as "NE/CNW $\frac{1}{4}$ SW $\frac{1}{4}$ " or footage from lines Center SE SE/4
Lease Owner A. C. Swaim
Lease Name William Lauda Well No. 1
Office Address 320 Indiana Bank Building, Evansville, Indiana
Character of Well (completed as Oil, Gas or Dry Hole) Dry Hole
Date well completed June 1, 19 52
Application for plugging filed June 9, 19 52
Application for plugging approved June 1, 19 52
Plugging commenced June 1, 19 52
Plugging completed June 1, 19 52
Reason for abandonment of well or producing formation Dry hole

If a producing well is abandoned, date of last production _____ 19_____
Was permission obtained from the Conservation Division or its agents before plugging was commenced? Yes

Name of Conservation Agent who supervised plugging of this well Eldon Petty
Producing formation _____ Depth to top _____ Bottom _____ Total Depth of Well 4040 Feet
Show depth and thickness of all water, oil and gas formations.

OIL, GAS OR WATER RECORDS

CASING RECORD

| Formation | Content | From | To | Size | Put In | Pulled Out |
|-----------|---------|------|----|-------|--------|------------|
| | | | | 8 5/8 | 212' | none |
| | | | | | | |
| | | | | | | |
Describe in detail the manner in which the well was plugged, indicating where the mud fluid was placed and the method or methods used in introducing it into the hole. If cement or other plugs were used, state the character of same and depth placed, from ~~10-10~~ feet to _____ feet for each plug set.
From 0 to 40 cemented with 10 sacks
From 40 to 145 mud
From 145 to 190 cemented with 15 sacks
From 190 to total depth 4040 mud

RECEIVED
JUN 14 1952
STATE CORPORATION COMMISSION
CONSERVATION DIVISION
Wichita, Kansas

6-14-52

(If additional description is necessary, use BACK of this sheet)
Correspondence regarding this well should be addressed to Lohmann-Johnson Drilling Co., Inc.
Address 320 Indiana Bank Building, Evansville, Indiana

STATE OF Indiana, COUNTY OF Vanderburgh, ss.
James W. Kendall (employee of owner) or (owner or operator) of the above-described well,
being first duly sworn on oath, says: That I have knowledge of the facts, methods, and matters herein contained and the log of the above-described well as filed and that the same are true and correct. So help me God.

(Signature) [Signature]
320 Indiana Bank Bldg, Evansville, Indiana
(Address)

SUBSCRIBED AND SWORN to before me this 9th day of June, 19 52

My commission expires October 14, 1953. [Signature] Notary Public.

23-3273-s 4-50-10M
PLUGGING
FILE SEC 4 T 4 R 21C
BOOK PAGE 21 LINE 24