


STATE OF KANSAS  
STATE CORPORATION COMMISSION

WELL PLUGGING RECORD

Give All Information Completely  
Make Required Affidavit  
Mail or Deliver Report to  
Conservation Division  
State Corporation Comm.  
245 North Water  
Wichita, KS 67202

Decatur County, Sec. 2 Twp. 4S Rge. 27W E/W  
Location as "NE/CNW $\frac{1}{4}$ /SW $\frac{1}{4}$ " or footage from lines  
C NW/4 SE/4

Lease Owner Bolyard Oil & Gas, Ltd.  
Lease Name Franklin Well No. 1  
Office Address 1020-15th Street, Suite 20C, Denver, Colo. 80202  
Character of Well (Completed as Oil, Gas or Dry Hole) \_\_\_\_\_

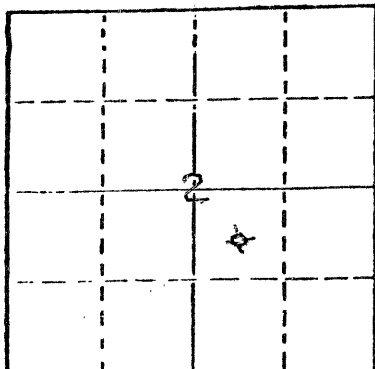

Locate well correctly on above  
Section Plat

D & A  
Date Well completed February 3, 1977  
Application for plugging filed February 3, 1977  
Application for plugging approved February 3, 1977  
Plugging commenced February 3, 1977  
Plugging completed February 3, 1977

Reason for abandonment of well or producing formation \_\_\_\_\_  
D & A  
If a producing well is abandoned, date of last production 19 \_\_\_\_\_

Was permission obtained from the Conservation Division or its agents before plugging was commenced? Yes \_\_\_\_\_

Name of Conservation Agent who supervised plugging of this well W. L. Nichols  
Producing formation \_\_\_\_\_ Depth to top \_\_\_\_\_ Bottom \_\_\_\_\_ Total Depth of Well 3775'  
Show depth and thickness of all water, oil and gas formations.

OIL, GAS OR WATER RECORDS

CASING RECORD

FORMATION	CONTENT	FROM	TO	SIZE	PUT IN	PULLED OUT
				8 5/8"	276.89'	-0-

Describe in detail the manner in which the well was plugged, indicating where the mud fluid was placed and the method or methods used in introducing it into the hold. If cement or other plugs were used, state the character of same and depth placed, from \_\_\_\_\_ feet to \_\_\_\_\_ feet for each plug set.

Plug #1 @ 1200' w/70 sx cement  
Plug #2 @ 240' w/20 sx cement  
Plug #3 @ 40' w/10 sx Cement  
(Cement was 50-50 Pozmix, 6% Gel)

FFB 14 1977

CONSERVATION DIVISION  
Wichita, Kansas

2-14-77

(If additional description is necessary, use BACK of this sheet)

Name of Plugging Contractor Red Tiger Drilling Company  
1720 KSB&T Building, Wichita, Kansas 67202

STATE OF Kansas COUNTY OF Sedgwick, ss.  
Gloria Fawcett (employee of ~~owner~~ contractor)  
of the above-described well, being first duly sworn on oath, says: That I have knowledge of the facts, statements, and matters herein contained and the log of the above-described well as filed and that the same are true and correct. So help me God.

(Signature) Gloria Fawcett  
1720 KSB&T Building, Wichita, Kansas 67202  
(Address)

SUBSCRIBED AND SWORN TO before me this 8th day of February, 1977.

My commission expires \_\_\_\_\_

Joyce A. Hagermann  
Notary Public.

