


Give All Information Completely  
Make Required Affidavit  
Mail or Deliver Report to:  
Conservation Division  
State Corporation Commission  
212 No. Market  
Wichita, Kansas

WELL PLUGGING RECORD

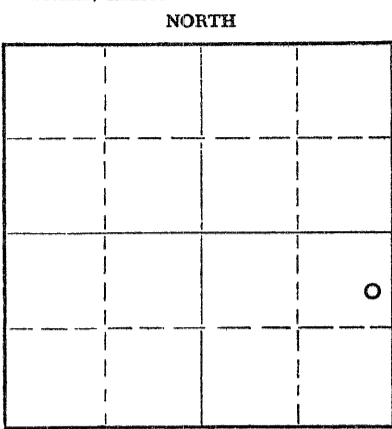

Locate well correctly on above Section Plat

DECATUR County, Sec. 10 Twp. 4 Rge. 27W (E)W (W)  
Location as "NE/CNW/SW" or footage from lines SE NE SE  
Lease Owner OKMAR OIL CO.  
Lease Name KUMP #1 Well No.  
Office Address 1130 WICHITA PLAZA, WICHITA, KANSAS 67202  
Character of Well (completed as Oil, Gas or Dry Hole) DRY HOLE  
Date well completed NOV. 20 19 68  
Application for plugging filed NOV. 20, 19 68  
Application for plugging approved NOV. 20, 19 68  
Plugging commenced NOV. 20, 19 68  
Plugging completed NOV. 20, 19 68  
Reason for abandonment of well or producing formation TOO LOW STRUCTURALLY

If a producing well is abandoned, date of last production 19  
Was permission obtained from the Conservation Division or its agents before plugging was commenced? YES

Name of Conservation Agent who supervised plugging of this well W. L. NICHOLS  
Producing formation Depth to top Bottom Total Depth of Well 3740' Feet  
Show depth and thickness of all water, oil and gas formations.

OIL, GAS OR WATER RECORDS

CASING RECORD

FORMATION	CONTENT	FROM	TO	SIZE	PUT IN	PULLED OUT
				8-5/8"	211.64'	NONE

Describe in detail the manner in which the well was plugged, indicating where the mud fluid was placed and the method or methods used in introducing it into the hole. If cement or other plugs were used, state the character of same and depth placed, from feet to feet for each plug set.

FILLED WITH HEAVY MUD TO 1350'. SET PLUG. PUT IN 70 SACKS CEMENT. FILLED WITH HEAVY MUD TO 215'. SET PLUG. PUT IN 20 SACKS CEMENT. FILLED TO TOP WITH 1 SACK HULLS AND 10 SACKS CEMENT.

RECEIVED  
STATE CORPORATION COMMISSION  
DEC 19 1968  
CONSERVATION DIVISION  
Wichita, Kansas

12-19-68

(If additional description is necessary, use BACK of this sheet)  
Name of Plugging Contractor C-G DRILLING CO.  
Address 1107 UNION NATIONAL BUILDING, WICHITA, KANSAS 67202

STATE OF KANSAS, COUNTY OF SEDGWICK, ss.  
JAY H GALLOWAY (employee of owner) or (operator) of the above-described well, being first duly sworn on oath, says: That I have knowledge of the facts, statements, and matters herein contained and the log of the above-described well as filed and that the same are true and correct. So help me God.

(Signature) JAY H GALLOWAY 1107 UNION NATIONAL BLDG.  
(Address)

SUBSCRIBED AND SWORN TO before me this 25th day of NOVEMBER, 19 68

Phyllis Buchanan  
PHYLLIS BUCHANAN Notary Public.

