


15-147-30173-00-00

STATE OF KANSAS
STATE CORPORATION COMMISSION

WELL PLUGGING RECORD

Give All Information Completely
Make Required Affidavit
Mail or Deliver Report to:
Conservation Division
State Corporation Commission
800 Biting Building
Wichita, Kansas

Phillips County. Sec. 36 Twp. 4S Rge. 20W (E).....(W)
Location as "NE/CNW $\frac{1}{4}$ /SW $\frac{1}{4}$ " or footage from lines NW NW SE
Lease Owner Rine Drlg. Co.
Lease Name O'Connell Well No. 1
Office Address Wichita, Kansas
Character of Well (completed as Oil, Gas or Dry Hole) Dry Hole
Date well completed 8-25 19 51
Application for plugging filed 8-25 19 51
Application for plugging approved 8-25 19 51
Plugging commenced 8-25 19 51
Plugging completed 8-25 19 51

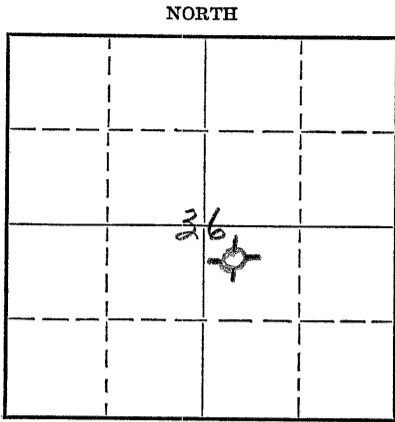

Locate well correctly on above
Section Plat

Reason for abandonment of well or producing formation.....
If a producing well is abandoned, date of last production..... 19.....
Was permission obtained from the Conservation Division or its agents before plugging was commenced?..... Yes

Name of Conservation Agent who supervised plugging of this well..... Harold Hollis
Producing formation..... Depth to top..... Bottom..... Total Depth of Well..... Feet
Show depth and thickness of all water, oil and gas formations.

OIL, GAS OR WATER RECORDS

CASING RECORD

Formation	Content	From	To	Size	Put In	Pulled Out
Surface Casing				8 5/8	209'	None

Describe in detail the manner in which the well was plugged, indicating where the mud fluid was placed and the method or methods used in introducing it into the hole. If cement or other plugs were used, state the character of same and depth placed, from..... feet to..... feet for each plug set.

Set wooden plug 150' off bottom, cemented w/15 sacks cement, filled up w/ rotary mud to 40' within top. Set wooden Plug @ 40' cemented to plan level w/10 sacks cement.

RECEIVED
STATE CORPORATION COMMISSION
SEP 14 1951
AUG 29 1951
8-29-51

(If additional description is necessary, use BACK of this sheet)

Correspondence regarding this well should be addressed to..... Rine Drilling Co., Wichita, Kansas
Address.....

STATE OF Kansas, COUNTY OF Barton, ss.
Contractor for Owner..... (employee of owner) or (owner or operator) of the above-described well,
being first duly sworn on oath, says: That I have knowledge of the facts, statements, and matters herein contained and the log of the above-described well as filed and that the same are true and correct. So help me God. HONAKER DRILLING COMPANY, INC.

(Signature) Earnest Fisher
(Address).....

SUBSCRIBED AND SWORN TO before me this 28 day of August, 19 51
Kenneth J. Fisher
Notary Public.

My commission expires 6-25-55

28-5091-s 8-50-10M

PLUGGING
FILE SEC 36 T 4 R 20W
BOOK PAGE 106 LINE 81

15-147-30173-00-00

DRILLERS LOG

O'CONNELL #1

Casing Record:
8 5/8" 207'

Company: R. W. Rine Drilling Co. Location: NW NW SE
36-45-20W
Contractor: Honaker Drilling Co., Phillips County, Kans
Inc.

Commenced: August 14, 1951 Elevation: 1926 GL.
Completed: August 25, 1951 Potential: Dry.

Formation	From	To	Remarks
Clay	0	75	
Shale	75	207	8 5/8" casing set at 207
Shale	207	310	cemented with 200 sacks.
Sand - Shale	310	810	
Shale - Shells	810	1260	
Shale - Shells	1260	1490	
Anhydrite	1490	1535	
Red Bed - Shale	1535	1750	
Shale - Shells	1750	1900	
Shale - Lime	1900	2110	
Shale - Lime	2110	2390	
Lime	2390	2480	
Lime - Shale	2480	2975	
Lime	2975	3060	
Lime - Shale	3060	3194	
Lime	3194	3232	
Lime - Shale	3232	3237	
Lime	3237	3350	
Lime - Shale	3350	3490	
Lime - Shale	3490	3512	
Conglomerate	3512	3524	
Arbuckle	3524	3574	T. D. Rotary

I certify that this is the true and correct copy of the above log, to the best of my knowledge.

Joe J. Honaker

Subscribed and sworn before me this 29th day of August 19 51

Kenneth S. Fischer
Notary Public

AUG 30 1951

CONSERVATION DIVISION

MY COMMISSION EXPIRES June 25, 1955.

8-30-51

PLUGGING
FILE SEC 36 T 4 R 20W
BOOK PAGE 106 LINE 21

O'CONNELL WELL No. 1

NW NW SE
SEC. 36-4S-20W
PHILLIPS COUNTY, KANSAS

CONTRACTOR: THE R. W. RINE DRILLING COMPANY

STARTED: AUGUST 14, 1951

FINISHED: AUGUST 25, 1951

LOG

CLAY	0 - 75	
SHALE	75 - 207	8 1/4" SURFACE PIPE @ 209'
SHALE	207 - 310	
SAND AND SHALE	310 - 810	
SHALE AND SHELLS	810 - 1260	
SHALE AND SHELLS	1260 - 1490	
ANHYDRITE	1490 - 1530	
ANHYDRITE	1530 - 1535	
SHALE AND SHELLS	1535 - 1900	
SHALE AND LIME	1900 - 2110	
LIME AND SHALE	2110 - 2390	
LIME	2390 - 2480	
LIME AND SHALE	2480 - 2785	
LIME AND SHALE	2785 - 2975	
LIME	2975 - 3060	
LIME AND SHALE	3060 - 3194	
LIME	3194 - 3232	
LIME AND SHALE	3232 - 3237	
LIME	3237 - 3350	
LIME AND SHALE	3350 - 3512	
CONGLOMERATE	3512 - 3524	
ARBUCKLE	3524 - 3555	
ARBUCKLE	3555 - 3574	T.D. - D & A

#1 PLUG AT 150' w/15 Sx.
#2 PLUG @ 40' w/10 Sx.

STATE OF KANSAS)
) ss.
COUNTY OF SEDGWICK)

I, R. M. GREEN, DO HEREBY CERTIFY THAT THE ABOVE IS A TRUE AND ACCURATE LOG OF THE O'CONNELL WELL No. 1, LOCATED IN THE NW NW SE, SECTION 36-4S-20W, PHILLIPS COUNTY, KANSAS.

R. M. Green
ASSISTANT SECRETARY

SUBSCRIBED TO AND SWORN BEFORE ME THIS 13TH DAY OF SEPTEMBER, 1951.

Leonal Pederson
NOTARY PUBLIC

MY COMMISSION EXPIRES APRIL 20, 1955

RECORDED
SEP 14 1951
9-14-51

PLUGGING
FILE SEC. 36-4-R-20W
BOOK PAGE 106 LINE 2