


19-147-20177-00-00

STATE OF KANSAS  
STATE CORPORATION COMMISSION  
CONSERVATION DIVISION  
P. O. BOX 17027  
WICHITA, KANSAS 67217

FORM CP-4

WELL PLUGGING RECORD

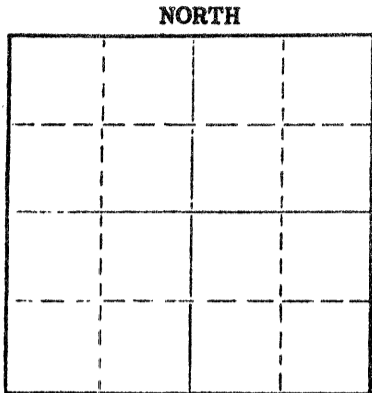

Locate well correctly on above Section Plat

Phillips County, Sec. 35 Twp. 4S Rge. 20W (E) (W) X  
C SE SE SE

Location as "NE/CNW&SW&" or footage from lines \_\_\_\_\_  
Lease Owner Petroleum Management, Inc.  
Lease Name McConnell Well No. 1  
Office Address 400 North Woodlawn, Suite 201, Wichita, Kansas 67208  
Character of Well (completed as Oil, Gas or Dry Hole) D & A  
Date well completed August 23 19 74  
Application for plugging filed August 23 19 74  
Application for plugging approved August 23 19 74  
Plugging commenced August 23 19 74  
Plugging completed August 23 19 74  
Reason for abandonment of well or producing formation D & A

If a producing well is abandoned, date of last production \_\_\_\_\_ 19 \_\_\_\_  
Was permission obtained from the Conservation Division or its agents before plugging was commenced? Yes

Name of Conservation Agent who supervised plugging of this well Mr. Leo F. Massey  
Producing formation \_\_\_\_\_ Depth to top \_\_\_\_\_ Bottom \_\_\_\_\_ Total Depth of Well 3397' Feet  
Show depth and thickness of all water, oil and gas formations.

OIL, GAS OR WATER RECORDS

CASING RECORD

FORMATION	CONTENT	FROM	TO	SIZE	PUT IN	PULLED OUT
				8-5/8"	207'	-0-

Describe in detail the manner in which the well was plugged, indicating where the mud fluid was placed and the method or methods used in introducing it into the hole. If cement or other plugs were used, state the character of same and depth placed, from \_\_\_\_\_ feet to \_\_\_\_\_ feet for each plug set.

Plug #1 @ 660' w/70 sx. cmt.  
Plug #2 @ 215' w/20 sx. cmt.  
Plug #3 @ 40' w/10 sx. cmt.  
Plugged w/100 sx. 50-50 pozmix, 6% gel.

RECEIVED  
STATE CORPORATION COMMISSION  
SEP 4 1974

CONSERVATION DIVISION  
Wichita, Kansas

(If additional description is necessary, use BACK of this sheet)  
Name of Plugging Contractor Red Tiger Drilling Company  
Address 1720 Wichita Plaza, Wichita, Kansas 67202

STATE OF Kansas COUNTY OF Sedgwick, ss.  
Linda H. Dickens (employee of owner) or (owner or operator) of the above-described

9-4-74

well, being first duly sworn on oath, says: That I have knowledge of the facts, statements, and matters herein contained and the log of the above-described well as filed and that the same are true and correct. So help me God.

(Signature) Linda H. Dickens

1720 Wichita Plaza, Wichita, Kansas 67202  
(Address)

SUBSCRIBED AND SWORN TO before me this 29th day of August, 19 74

My commission expires December 28, 1977

D'Ann Drennan  
Notary Public.

