

CARD MUST BE TYPED

State of Kansas

CARD MUST BE SIGNED

NOTICE OF INTENTION TO DRILL

(see rules on reverse side)

Expected Spud Date. 12 19 88
month day year

API Number 15— 039 - 20,838 - 00-00

OPERATOR: License # 3916
Name Felmont Oil Corporation
Address P. O. Box 2266
City/State/Zip Midland, Texas 79702
Contact Person Mr. Tom Cathey
Phone 915-682-5231

NW SE NE Sec. 29 Twp. 4 S, Rg. 26W — East
3630 Ft. from South Line of Section
990 Ft. from East Line of Section

(Note: Locate well on Section Plat on reverse side)

CONTRACTOR: License # 5302
Name Red Tiger Drilling Co.
City/State Wichita, Kansas 67202

Nearest lease or unit boundary line 990 feet
County Decatur
Lease Name Hardesty 29 Well # 1

Well Drilled For: Well Class: Type Equipment:
 Oil Storage Infield Mud Rotary
 Gas Inj Pool Ext. Air Rotary
 OWWO Expl Wildcat Cable

Ground surface elevation 2587 feet MSL
Domestic well within 330 feet: yes no
Municipal well within one mile: yes no
Depth to bottom of fresh water 180 feet
Depth to bottom of usable water 1350 feet

If OWWO: old well info as follows:
Operator
Well Name
Comp Date Old Total Depth

Surface pipe by Alternate: 1 2
Surface pipe planned to be set 275 feet
Conductor pipe required N/A feet
Projected Total Depth 4500 feet
Formation ARB

I certify that well will comply with K.S.A. 55-101, et seq., plus eventually plugging holes to KCC specifications.
Date 2-19-88 Signature of Operator or Agent *Harold A. Angle* Owner

For KCC Use:
Conductor Pipe Required feet; Minimum Surface Pipe Required 200 feet per Alt. 2
This Authorization Expires 6-20-89 Approved by LKM 12 - 20-88


EFFECTIVE DATE: 12-25-89

Must be filed with the K.C.C. five (5) days prior to commencing well
 This card void if drilling not started within six (6) months of date received by K.C.C.

Important procedures to follow:

1. Notify District office before setting surface casing.
2. Set surface casing by circulating cement to the top.
3. File completion forms ACO-1 with K.C.C. within 120 days of well spud date, following instructions on ACO-1, side 1, and including copies of wireline logs.
4. Notify District office 48 hours prior to old well workover or re-entry.
5. Prior to filing Intent, prepare a proposed plugging plan in case well is D & A, then obtain approval of plan when calling district office prior to setting surface pipe.
6. Submit plugging report (CP-4) to K.C.C. after plugging is completed.

**A Regular Section of Land
 1 Mile = 5,280 Ft.**

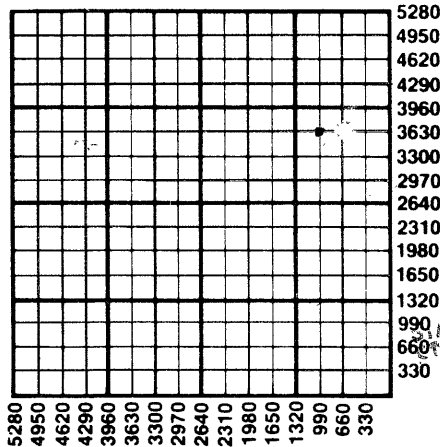

RECEIVED
 STATE CORPORATION COMMISSION
 WICHITA, KANSAS
 DEC 20 1988

7. Obtain an approved injection docket number before disposing of salt water.
8. Notify K.C.C. within 10 days when injection commences or terminates.
9. Plug alternate 2 completion, cement in the production pipe from any usable water to surface within 120 days of spud date.

CONSERVATION DIVISION
 Wichita, Kansas
 12-20-88

State Corporation Commission of Kansas
 Conservation Division
 200 Colorado Derby Building
 Wichita, Kansas 67202-1212
 (316) 263-3238