

15-147-00090-00-00


STATE OF KANSAS
STATE CORPORATION COMMISSION

Give All Information Completely
Make Required Affidavit
Mail or Deliver Report to:
Conservation Division
State Corporation Commission
800 Biting Building
Wichita, Kansas

WELL PLUGGING RECORD

Phillips County. Sec. 26 Twp. 4 Rge. 20 (E) W (W)
Location as "NE/CNW/SW" or footage from lines NW NW NW
Lease Owner D. G. Hansen
Lease Name Baldwin Well No. 1
Office Address Logan, Kansas
Character of Well (completed as Oil, Gas or Dry Hole) Dry Hole
Date well completed August 12, 1953
Application for plugging filed 8-12 1953
Application for plugging approved 8-12 1953
Plugging commenced 8-12 1953
Plugging completed 8-12 1953
Reason for abandonment of well or producing formation Too low structurally

NORTH

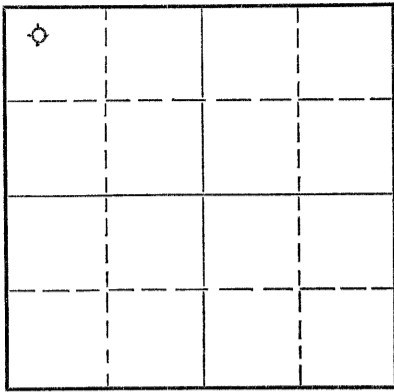

Locate well correctly on above
Section Plat

Name of Conservation Agent who supervised plugging of this well Eldon Petty, Hays, Kansas
Producing formation -- Depth to top -- Bottom -- Total Depth of Well -- Feet
Show depth and thickness of all water, oil and gas formations.

OIL, GAS OR WATER RECORDS

CASING RECORD

FORMATION	CONTENT	FROM	TO	SIZE	PUT IN	PULLED OUT
				8-5/8"	166.01	

Describe in detail the manner in which the well was plugged, indicating where the mud fluid was placed and the method or methods used in introducing it into the hole. If cement or other plugs were used, state the character of same and depth placed, from feet to feet for each plug set.

Filled hole with mud to 160'. Set solid plug; 1/2 sack hulls, 15 sacks cement. Filled hole with mud to 40'; set plug then filled to top with 10 sacks cement 1/2 sack hulls

RECEIVED
STATE CORPORATION COMMISSION
AUG 15 1953
CONSERVATION DIVISION
Wichita, Kansas
8-18-53

(If additional description is necessary, use BACK of this sheet)
Name of Plugging Contractor C-G DRILLING CO.
Address 544 Petroleum Building, Wichita, Kansas

STATE OF KANSAS, COUNTY OF SEDGWICK, ss.
Vicky Jacobs (employee of owner) or (~~owner or operator~~) of the above-described well, being first duly sworn on oath, says: That I have knowledge of the facts, statements, and matters herein contained and the log of the above-described well as filed and that the same are true and correct. So help me God.

(Signature) Vicky Jacobs Office Manager
544 Petroleum Building, Wichita, Kansas (Address)

SUBSCRIBED AND SWORN TO before me this 17th day of August, 19 53

Barbara Donaldson
Notary Public.

My commission expires June 17, 1957

24-7368-S 3-53-20M

PLUGGING
FILE SEC 26 T 4 R 20 W
BOOK PAGE 122 1117 15