


STATE OF KANSAS  
STATE CORPORATION COMMISSION

Give All Information Completely  
Make Required Affidavit  
Mail or Deliver Report to:  
Conservation Division  
State Corporation Commission  
211 No. Broadway  
Wichita, Kansas

WELL PLUGGING RECORD

15-147-00639-00-00

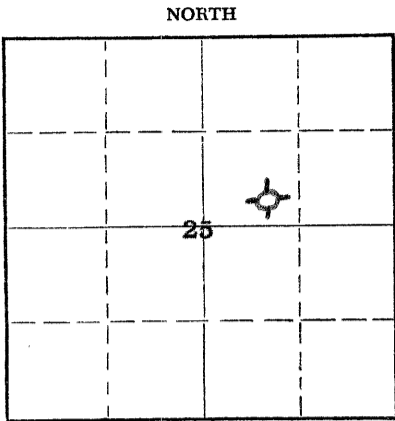

Locate well correctly on above Section Plat

Phillips County. Sec. 25 Twp. 4S Rge. (E) 20 (W)  
Location as "NE/CNW/SW" or footage from lines SE SW NE  
Lease Owner Rine Drilling Company  
Lease Name Lynch "B" Well No. 2  
Office Address 420 Union Center Bldg, Wichita 2, Kansas  
Character of Well (completed as Oil, Gas or Dry Hole) Dry Hole  
Date well completed August 7 1960  
Application for plugging filed August 7 1960  
Application for plugging approved August 7 1960  
Plugging commenced August 7 1960  
Plugging completed August 7 1960  
Reason for abandonment of well or producing formation Dry Hole

If a producing well is abandoned, date of last production - 19-  
Was permission obtained from the Conservation Division or its agents before plugging was commenced? Yes

Name of Conservation Agent who supervised plugging of this well Eldon Petty  
Producing formation - Depth to top - Bottom - Total Depth of Well 3240 Feet  
Show depth and thickness of all water, oil and gas formations.

OIL, GAS OR WATER RECORDS

CASING RECORD

FORMATION	CONTENT	FROM	TO	SIZE	PUT IN	PULLED OUT
				8-5/8"	164'	0

Describe in detail the manner in which the well was plugged, indicating where the mud fluid was placed and the method or methods used in introducing it into the hole. If cement or other plugs were used, state the character of same and depth placed, from \_\_\_\_\_ feet to \_\_\_\_\_ feet for each plug set.

Heavy rotary mud was placed to 600 feet with the drill pipe.  
A wooden plug and 20 sacks of cement were placed at 600 feet.  
Heavy rotary mud to 160 feet.  
A wooden plug and 15 sacks of cement were placed at 160 feet.  
Heavy rotary mud to 40 feet.  
1/2 sack hulls, a wooden plug and 10 sacks of cement were placed at 40 feet.

RECEIVED  
STATE CORPORATION COMMISSION

AUG 18 1960

DIVISION

(If additional description is necessary, use BACK of this sheet)  
Name of Plugging Contractor Stickle Drilling Company  
Address 1100 Bitting Building, Wichita 2, Kansas

STATE OF Kansas, COUNTY OF Sedgwick, ss.  
R. M. Green (employee of owner) or owner or operator of the above-described well, being first duly sworn on oath, says: That I have knowledge of the facts, statements, and matters herein contained and the log of the above-described well as filed and that the same are true and correct. So help me God.

(Signature) R. M. Green  
Secretary-Treasurer  
420 Union Center, Wichita, Kansas  
(Address)

SUBSCRIBED AND SWORN TO before me this 17th day of August, 1960

My commission expires June 14, 1967  
J. E. Sale Notary Public.

R. W. Rine Drilling Company  
Wichita, Kansas

Tulsa, Oklahoma  
August 15, 1960

Contractor: Stickle Drilling Company  
Date Commenced: August 1, 1960  
Date Completed: August 7, 1960


Lynch "B" No. 2,  
SE SW NE Sec. 25-48-20W  
Phillips County, Kansas

DRILLER'S LOG

Depth Figures Indicate Base of Formation:

Surface clay and shells	166
Shale	605
Sand and shale streaks	1040
Sand	1255
Sand and shale	1508
Anhydrite	1535
Shale and shells	2335
Shale and lime	2555
Shale and shells	2755
Lime and shale	3105
Lime	3240 TD

I, Fred E. Stickle, hereby certify the above to be a true and complete Driller's Log of the R. W. Rine Drilling Company's Lynch "B" Well No. 2, SE SW NE of Section 25-48-20W., Phillips County, Kansas.

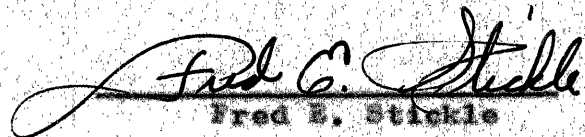  
Fred E. Stickle

Edith A. Lawner  
Notary Public

My commission expires March 24, 1964

RECEIVED  
CORPORATION COMMISSION  
AUG 22 1960  
CONSERVATION DIVISION  
Wichita, Kansas

822-60