


sent to state

15-147-00140-06-00

STATE OF KANSAS
STATE CORPORATION COMMISSION
Give All Information Completely
Make Required Affidavit
Mail or Deliver Report to:
Conservation Division
State Corporation Commission
211 No. Broadway
Wichita, Kansas

WELL PLUGGING RECORD

Phillips County. Sec. 25 Twp. 4 Rge. 20 (E) (W)
Location as "NE/CNW/SW" or footage from lines C SE NW
Lease Owner R. W. Rine Drilling Company
Lease Name Lynch Well No. "A" # 1
Office Address % Calvin Roe Star Route Pratt, Kansas
Character of Well (completed as Oil, Gas or Dry Hole) Oil
Date well completed 8-4-59
Application for plugging filed yes
Application for plugging approved yes
Plugging commenced 10-2-60
Plugging completed 10-10-60
Reason for abandonment of well or producing formation Oil exhausted

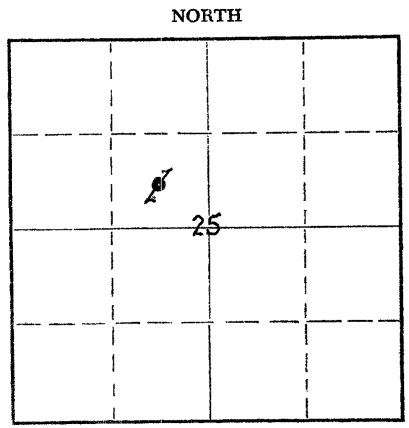

Locate well correctly on above Section Plat

If a producing well is abandoned, date of last production July 25, 19 60
Was permission obtained from the Conservation Division or its agents before plugging was commenced? yes

Name of Conservation Agent who supervised plugging of this well Eldon Petty
Producing formation Lansing Depth to top 3139 Bottom 3353 P.B. Total Depth of Well 3111 Feet
Show depth and thickness of all water, oil and gas formations. Rotary Total Depth of Well 3480 Feet

OIL, GAS OR WATER RECORDS				CASING RECORD		
FORMATION	CONTENT	FROM	TO	SIZE	PUT IN	PULLED OUT
				5 1/2"	3462	2400'
				8-5/8	224	0'

Describe in detail the manner in which the well was plugged, indicating where the mud fluid was placed and the method or methods used in introducing it into the hole. If cement or other plugs were used, state the character of same and depth placed, from _____ feet to _____ feet for each plug set.

Plugging commenced 10-2-60. Plugging completed 10-10-60.
Measured into total depth, 3111'. Plugged off bottom:
Sanded back to 3115' and dumped 4 sacks of cement. Worked and shot casing. Spotted oil. Worked and shot 5 1/2" casing free at 2400'. Built rack and slide. Pulled and laid down casing. Plugged hole: Mudded hole up to 220'. Set 10' rock bridge at 220'. Dumped 20 sacks of cement. Mudded hole up to 40'. Set 10' rock bridge at 40'. Capped the well with 10 sacks of cement.

RECEIVED
STATE CORPORATION COMMISSION

OCT 14 1960

CONSERVATION DIVISION
Wichita, Kansas

(If additional description is necessary, use BACK of this sheet)
Name of Plugging Contractor J. O. Forbes d/b/a Forbes Casing Pulling Co. 10-14-60
Address Box 221 Great Bend, Kansas

STATE OF Kansas, COUNTY OF Barton, ss.
J. O. Forbes (employee of owner) or (owner or operator) of the above-described well, being first duly sworn on oath, says: That I have knowledge of the facts, statements, and matters herein contained and the log of the above-described well as filed and that the same are true and correct. (So help me God.)

(Signature) J. O. Forbes
Box 221 Great Bend, Kansas
(Address)

SUBSCRIBED AND SWORN TO before me this 11th day of October, 1960

My commission expires December 8th, 1963
Kayann Jenkins Notary Public.



13-147-00140-00-00

DRILLER'S WELL LOG

OPERATOR: R. W. RINE DRILLING COMPANY
420 Union Center Building
Wichita 2, Kansas

WELL NAME: #1 LYNCH 'A'
LOCATION: C SE NW
Sec. 25-4S-20W
PHILLIPS CO, KANSAS

CONTRACTOR: K & E DRILLING, INC.
719 UNION CENTER BLDG.
WICHITA, KANSAS

COMMENCED: May 6th, 1959
COMPLETED: May 14th, 1959

CASING RECORD: 8-5/8" @ 224' (150 sx cmt)
5-1/2" @ 3462' (100 sx cmt)

ELEVATION: ~~unknown~~ 1986

ROTARY TOTAL DEPTH: 3480'

PRODUCTION: ~~unknown~~ 30.80 + 79% wbr

FORMATION RECORD

Depths shown indicate bottom of formations encountered.

Surface Soil & Clay	40
Blue Shale	224
Shale & Sand	1505
Anhydrite	1545
Shale & Shells	2045
Shale & Lime	2365
Lime & Shale	2980
Lime	3380
Shale & Lime	3440
Lime	3480
R.T.D.	3480

RECEIVED
STATE CORPORATION COMMISSION

OCT 14 1960

CONSERVATION DIVISION
Wichita, Kas.

10-14-60

CERTIFICATION

State of KANSAS }
County of SEDGWICK } ss:

I, DALE SILCOTT, of K&E DRILLING, INC., upon oath state that the above and foregoing is a true and correct copy of the Driller's Log of the above named well.

Dale Silcott
Dale Silcott

Subscribed and sworn to before me this 18th day of May, 19 59.

Patricia M. Edwards
Patricia M. Edwards, Notary Public.

My Commission expires: August 11th, 1962.

