


STATE OF KANSAS  
STATE CORPORATION COMMISSION

WELL PLUGGING RECORD

Give All Information Completely  
Make Required Affidavit  
Mail or Deliver Report to  
Conservation Division  
State Corporation Comm.  
245 North Water  
Wichita, KS 67202

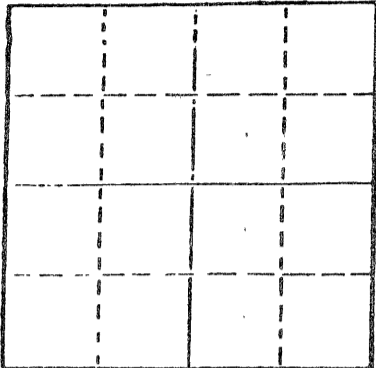

Locate well correctly on above  
Section Plot

Phillips County. Sec. 27 Twp. 4 Rge. 20 ~~N~~/W  
Location as "NE/CNW $\frac{1}{4}$ SW $\frac{1}{4}$ " or footage from lines  
NW NW SE

Lease Owner Lawbanco Drilling, Inc.  
Lease Name Schurz Well No. 1  
Office Address Box 289 Natoma, Kansas 67651  
Character of Well (Completed as Oil, Gas or Dry Hole)  
dry hole  
Date Well completed 7-10-82 19  
Application for plugging filed 7-10-82 19  
Application for plugging approved 7-10-82 19  
Plugging commenced 10:30 A.M. 7-10-82 19  
Plugging completed 11:45 A.M. 7-10-82 19  
Reason for abandonment of well or producing formation \_\_\_\_\_

If a producing well is abandoned, date of last production \_\_\_\_\_ 19

Was permission obtained from the Conservation Division or  
its agents before plugging was commenced? yes

Name of Conservation Agent who supervised plugging of this well Carl Goodrow  
Producing formation \_\_\_\_\_ Depth to top \_\_\_\_\_ Bottom \_\_\_\_\_ Total Depth of Well \_\_\_\_\_  
Show depth and thickness of all water, oil and gas formations.

OIL, GAS OR WATER RECORDS

CASING RECORD

FORMATION	CONTENT	FROM	TO	SIZE	PUT IN	PULLED OUT

Describe in detail the manner in which the well was plugged, indicating where the mud fluid was placed and the method or methods used in introducing it into the hold. If cement or other plugs were used, state the character of same and depth placed, from \_\_\_\_\_ feet to \_\_\_\_\_ feet for each plug set.

80 sacks at 800'  
40 sacks at 250'  
10 sacks at 40' with 1 sack hulls & plug for solid bridge  
10 sacks for rat hole  
Total 140 sacks 50/50 poz 4% gel 3% cc

(If additional description is necessary, use BACK of this sheet)


Name of Plugging Contractor Lawbanco Drilling, Inc.  
Box 289 Natoma, Kansas 67651

STATE OF Kansas COUNTY OF Osborne, ss.  
R. L. Finney (employee of owner) or (owner or operator)  
of the above-described well, being first duly sworn on oath, says: ~~That~~ I have knowledge of the facts, statements, and matters herein contained and the log of the above-described well as filed and that the same are true and correct. So help me God.

(Signature) R. L. Finney  
2220 Marjorie Hays, Kansas 67601  
(Address)

SUBSCRIBED AND SWORN TO before me this 22nd day of July, 1982

My commission expires 4-20-83

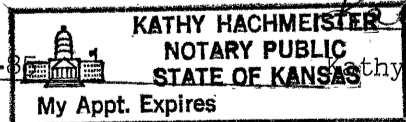

Kathy Hachmeister  
Notary Public

RECEIVED  
STATE CORPORATION COMMISSION  
Notary Public.

JUL 23 1982

CONSERVATION DIVISION  
Wichita, Kansas

7-23-82