


15-137-00249-06-00

STATE OF KANSAS
STATE CORPORATION COMMISSION

Give All Information Completely
Make Required Affidavit
Mail or Deliver Report to:
Conservation Division
State Corporation Commission
211 No. Broadway
Wichita, Kansas

WELL PLUGGING RECORD

NORTH

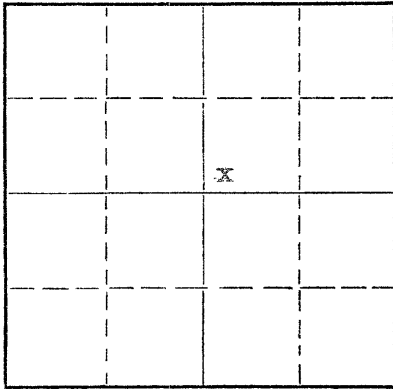

Locate well correctly on above
Section Plat

Norton County. Sec. 11 Twp. 4S Rge. 25 (E) W (W)
Location as "NE/CNW/SW" or footage from lines C/SW SW NE
Lease Owner Aurora Gasoline Company
Lease Name Zimmerman Well No. 1
Office Address 802 Union National Building, Wichita 2, Kansas
Character of Well (completed as Oil, Gas or Dry Hole) Dry Hole
Date well completed August 13 1956
Application for plugging filed August 13 1956
Application for plugging approved August 13 1956
Plugging commenced August 13 1956
Plugging completed August 13 1956
Reason for abandonment of well or producing formation Dry

If a producing well is abandoned, date of last production _____ 19____
Was permission obtained from the Conservation Division or its agents before plugging was commenced? Yes

Name of Conservation Agent who supervised plugging of this well Eldon Petty
Producing formation _____ Depth to top _____ Bottom _____ Total Depth of Well 3980 Feet
Show depth and thickness of all water, oil and gas formations.

OIL, GAS OR WATER RECORDS

CASING RECORD

FORMATION	CONTENT	FROM	TO	SIZE	PUT IN	PULLED OUT
				8 5/8"	162'	

Describe in detail the manner in which the well was plugged, indicating where the mud fluid was placed and the method or methods used in introducing it into the hole. If cement or other plugs were used, state the character of same and depth placed, from _____ feet to _____ feet for each plug set.

Mud up to 160'. Drove down 1/3 sack hulls. Set Halliburton plug @ 160' with 15 sacks bulk cement. Set Second Halliburton plug @ 40' with 10 sacks cement.

RECEIVED
STATE CORPORATION COMMISSION
AUG 17 1956
CONSERVATION DIVISION
Wichita, Kansas
8-17-56

(If additional description is necessary, use BACK of this sheet)
Name of Plugging Contractor Kan-Tex Drillers, Inc.
Address 413 Beacon Building, Wichita 2, Kansas

STATE OF Kansas, COUNTY OF Sedgewick, ss.
Harvey E. Nightingale (employee of owner) or (owner or operator) of the above-described well, being first duly sworn on oath, says: That I have knowledge of the facts, statements, and matters herein contained and the log of the above-described well as filed and that the same are true and correct. So help me God.

(Signature) Harvey E. Nightingale
413 Beacon Building, Wichita 2, Kansas
(Address)

SUBSCRIBED AND SWORN TO before me this 14 day of August, 1956
Barbara Larimer Notary Public.

My commission expires 12-27-59

PLUGGING
FILE SEC 11 T 4 R 25W
BOOK PAGE 90 LINE 22