


STATE OF KANSAS
STATE CORPORATION COMMISSION

Give All Information Completely
Make Required Affidavit
Mail or Deliver Report to:
Conservation Division
State Corporation Commission
211 No. Broadway
Wichita, Kansas

15-039-00138-00-00

WELL PLUGGING RECORD

NORTH

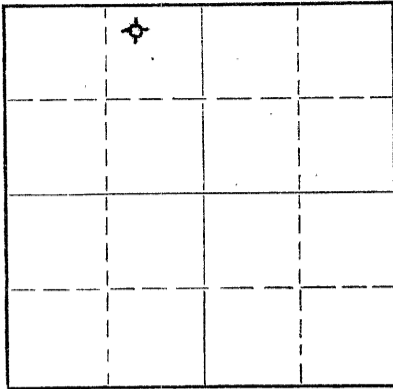

Locate well correctly on above
Section Plat

Decatur County. Sec. 19 Twp. 4S Rge. 26 (H) W (W)
Location as "NE/CNW/SW" or footage from lines NW NE NW
Lease Owner R. W. Shields & C-G Drilling Co
Lease Name Tacha Well No. 1
Office Address 308 Rule Building, Wichita, Kansas
Character of Well (completed as Oil, Gas or Dry Hole) dry hole
Date well completed July 26 1959
Application for plugging filed " " 1959
Application for plugging approved " " 1959
Plugging commenced " " 1959
Plugging completed " " 1959
Reason for abandonment of well or producing formation Too low structurally

If a producing well is abandoned, date of last production - 19 -
Was permission obtained from the Conservation Division or its agents before plugging was commenced? yes

Name of Conservation Agent who supervised plugging of this well Eldon Petty
Producing formation _____ Depth to top _____ Bottom _____ Total Depth of Well 3730 Feet
Show depth and thickness of all water, oil and gas formations.

OIL, GAS OR WATER RECORDS

CASING RECORD

FORMATION	CONTENT	FROM	TO	SIZE	PUT IN	PULLED OUT
				8 5/8"	256'	none

Describe in detail the manner in which the well was plugged, indicating where the mud fluid was placed and the method or methods used in introducing it into the hole. If cement or other plugs were used, state the character of same and depth placed, from _____ feet to _____ feet for each plug set.

Filled hole with heavy mud to 600' Set plug.
Put in 20 sacks cement; filled with heavy mud to 250'.
Set plug. Put in 20 sacks cement and 1/2 sacks
hulls; filled with heavy mud to 40'. Set plug.
Filled to top with 10 sacks cement and 1/2 sack
hulls.


RECEIVED
STATE COR.
JUL 31 1959
CONSERVATION DIVISION
Wichita, Kansas
17-31-59

(If additional description is necessary, use BACK of this sheet)
Name of Plugging Contractor C-G Drilling Co.
Address 107 Rule Building, Wichita, Kansas

STATE OF Kansas, COUNTY OF Sedgwick, ss.
Jay H. Galloway (employee of owner) or (owner or operator) of the above-described well, being first duly sworn on oath, says: That I have knowledge of the facts, statements, and matters herein contained and the log of the above-described well as filed and that the same are true and correct. So help me God.

(Signature) Jay H. Galloway
107 Rule Building, Wichita, Kansas
(Address)

SUBSCRIBED AND SWORN to before me this 27 day of July, 1959
My commission expires May 20, 1963
Wicky Jacobs Notary Public.

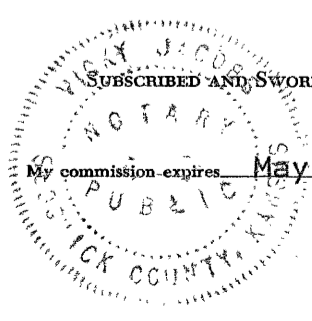

PLUGGING
FILE SEC. 19 T. 4 R. 26
BOOK PAGE 56 LINE 23