


15-039-00039-00-00

STATE OF KANSAS
STATE CORPORATION COMMISSION

Give All Information Completely
Make Required Affidavit
Mail or Deliver Report to:
Conservation Division
State Corporation Commission
800 Bitting Building
Wichita, Kansas

WELL PLUGGING RECORD

Decatur County. Sec. 12 Twp. 4 Rge. (E) 26 (W)
Location as "NE/CNW $\frac{1}{4}$ SW $\frac{1}{4}$ " or footage from lines NW NW NW
Lease Owner Harry Gore
Lease Name Norris Well No. 1
Office Address 400 Brown Building, Wichita, Kansas
Character of Well (completed as Oil, Gas or Dry Hole) Dry Hole
Date well completed September 23, 19 51
Application for plugging filed September 23, 19 51
Application for plugging approved September 23, 19 51
Plugging commenced September 23, 19 51
Plugging completed September 23, 19 51
Reason for abandonment of well or producing formation

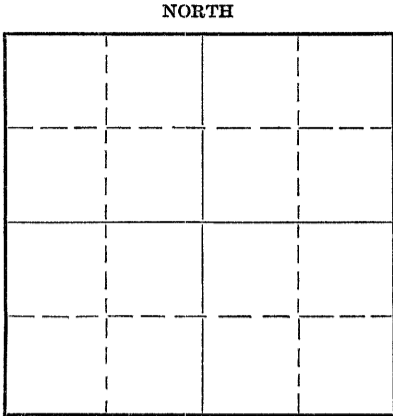

Locate well correctly on above Section Plat

If a producing well is abandoned, date of last production 19
Was permission obtained from the Conservation Division or its agents before plugging was commenced? Yes

Name of Conservation Agent who supervised plugging of this well Eldon Petty, Hays, Kansas
Producing formation Depth to top Bottom Total Depth of Well 3920 Feet
Show depth and thickness of all water, oil and gas formations.

OIL, GAS OR WATER RECORDS

CASING RECORD

Formation	Content	From	To	Size	Put In	Pulled Out
				8-5/8"	219'	Cemented

Describe in detail the manner in which the well was plugged, indicating where the mud fluid was placed and the method or methods used in introducing it into the hole. If cement or other plugs were used, state the character of same and depth placed, from feet to feet for each plug set.

Filled hole with heavy mud to 210'. Set Plug and run $\frac{1}{2}$ sack of hulls and 15 sacks of cement on top of plug. Filled hole to 40' set plug and on top of plug put $\frac{1}{2}$ sack of hulls and 10 sacks of cement. This filled hole to top of surface.

10-9-51

(If additional description is necessary, use BACK of this sheet)

Correspondence regarding this well should be addressed to Harry Gore
Address 400 Brown Building
Wichita, Kansas

STATE OF KANSAS, COUNTY OF MONTGOMERY, ss.
PERRY A. MASON (employee of owner) or (owner or operator) of the above-described well,
being first duly sworn on oath, says: That I have knowledge of the facts, statements, and matters herein contained and the log of the above-described well as filed and that the same are true and correct. So help me God, THE VEEDER SUPPLY AND DEVELOPMENT COMPANY
(Signature) Perry A. Mason
P. O. Box 201, Cherryvale, Kansas
(Address)

SUBSCRIBED AND SWORN TO before me this 27th day of September, 19 51
Eldon Lawson
Notary Public.

My commission expires July 11, 1952

PLUG
FILE SEC 12 Twp 4 Rge 26
BOOK PAGE 111 LINE 26