

WELL PLUGGING RECORD

Give All Information Completely  
Make Required Affidavit  
Mail or Deliver Report to  
Conservation Division  
State Corporation Comm.  
200 Colorado Derby Bldg.  
202 W. 1st St.  
Wichita, KS 67202

Phillips County Sec. 15 Twp. 4s Rge. 19 ~~NE~~/W  
Location as "NE/CNW/SW" or footage from lines \_\_\_\_\_

NW NW NE

Lease Owner American Petroleum Company, Inc.

Lease Name EHM Well No. #1

Office Address 400 North Woodlawn Suite 111 Wichita, Ks 67208

Character of Well (Completed as Oil, Gas or Dry Hole) \_\_\_\_\_  
Dry Hole

Date Well completed March 16 19 82

Application for plugging filed March 15 19 82

Application for plugging approved March 16 19 82

Plugging commenced 2:00 P.M. March 16 19 82

Plugging completed 3:15 P.M. March 16 19 82

Reason for abandonment of well or producing formation \_\_\_\_\_  
No Commercial Production

If a producing well is abandoned, date of last production \_\_\_\_\_ 19 \_\_\_\_\_


Was permission obtained from the Conservation Division or its agents before plugging was commenced? Yes

Name of Conservation Agent who supervised plugging of this well Marion Schmidt

Producing formation \_\_\_\_\_ Depth to top \_\_\_\_\_ Bottom \_\_\_\_\_ Tl. Depth of Well \_\_\_\_\_

Show depth and thickness of all water, oil and gas formations.

locate well correctly  
on above  
Section Plot

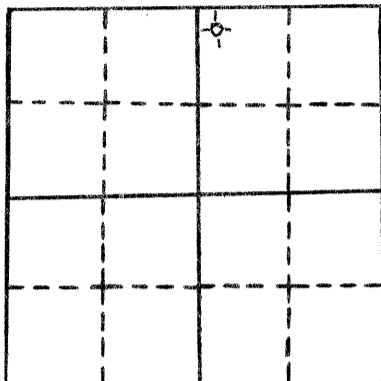

OIL, GAS OR WATER RECORDS

CASING RECORD

FORMATION	CONTENT	FROM	TO	SIZE	PUT IN	PULLED OUT
Surface Casing	common	0'	232'	8 5/8"	232'	0'

Describe in detail the manner in which the well was plugged, indicating where the mud fluid was placed and the method or methods used in introducing it into the hold. If cement or other plugs were used, state the character of same and depth placed, from \_\_\_\_\_ feet to \_\_\_\_\_ feet for each plug set.

Plug # 1 800' with 70sxs

Plug # 2 240' with 40sxs

Plug # 3 40' with 10sxs

10sxs in rathole

Total--130sxs 50-50pos 6%gel 2%cc

P.D.@ 3:15 P.M. 3-16-82

(If additional description is necessary, use BACK of this sheet)

Name of Plugging Contractor Pioneer Drilling Company  
308 West Mill Plainville, Ks 67663

STATE OF KANSAS COUNTY OF SEDGWICK, ss.

JAMES T. BARVAIS (employee of owner) or (owner or operator) above described well, being first duly sworn on oath, says: That I have knowledge of the facts, statements, and matters herein contained and the log of the above described well is filed and that the same are true and correct. So help me God.

(Signature) *James T. Barvais*  
(Address) 400 NORTH WOODLAWN SUITE 111 WICHITA, KANSAS 67208

RECEIVED  
STATE CORPORATION COMMISSION  
MAR 22 1982  
03-22-1982  
CONSERVATION DIVISION  
WICHITA, KANSAS

SUBSCRIBED AND SWORN TO before me this 19TH. day of MARCH, 19 82

My commission expires 1-22-85

*Jeggy Benda*  
Notary Public