

STATE OF KANSAS
STATE CORPORATION COMMISSION

Give All Information Completely
Make Required Affidavit
Mail or Deliver Report to:
Conservation Division
State Corporation Commission
211 No. Broadway
Wichita, Kansas

15-147-00118-00-00
WELL PLUGGING RECORD

NORTH

Locate well correctly on above
Section Plat

Phillipsburg County, Sec. 16 Twp. 4 Rge. 19 (E) W (W)
Location as "NE/CNW/SWK" or footage from lines NE NE NW
Lease Owner John Farmer, Inc.
Lease Name Bales #1 Well No.
Office Address Russell, Kansas
Character of Well (completed as Oil, Gas or Dry Hole)
Date well completed 19
Application for plugging filed 19
Application for plugging approved 19
Plugging commenced 1-30-58 19
Plugging completed 2-6-58 19
Reason for abandonment of well or producing formation

If a producing well is abandoned, date of last production 19
Was permission obtained from the Conservation Division or its agents before plugging was commenced? yes

Name of Conservation Agent who supervised plugging of this well Eldon Petty
Producing formation Depth to top Bottom Total Depth of Well 3400' Feet
Show depth and thickness of all water, oil and gas formations.

OIL, GAS OR WATER RECORDS

CASING RECORD

FORMATION	CONTENT	FROM	TO	SIZE	PUT IN	PULLED OUT
				8-5/8"	163'	none
				5-1/2"	3430'	2379'

Describe in detail the manner in which the well was plugged, indicating where the mud fluid was placed and the method or methods used in introducing it into the hole. If cement or other plugs were used, state the character of same and depth placed, from feet to feet for each plug set.

Checked the hole to 3280' and found it open.
Filled w/sand to 3200' and ran 4 sacks of
cement. Pulled 57 jts of 5 1/2" casing, and
pumped in 25 sacks of gel mud and 20 sacks
of cement. Pulled casing to 200' and pumped
in 15 sacks of cement. Pulled rest of pipe.
Bailed hole, set a rock bridge and ran 10
sacks of cement to base of cellar.

RECEIVED
STATE CORPORATION COMMISSION

FEB 11 1958
02-11-1958
CONSERVATION DIVISION
Wichita, Kansas

(If additional description is necessary, use BACK of this sheet)

Name of Plugging Contractor West Supply Co., Inc.
Address Chase, Kansas

STATE OF KANSAS, COUNTY OF RICE, ss.
John O. Farmer (employee of owner) or (owner or operator) of the above-described

well, being first duly sworn on oath, says: That I have knowledge of the facts, statements, and matters herein contained and the log of the above-described well as filed and that the same are true and correct. So help me God.

(Signature)

Russell, Kansas
(Address)

SUBSCRIBED AND SWORN TO before me this 7th day of February, 1958

Thomas V. Huggin

Notary Public.

My commission expires 7-27-58


PLUGGING
FILE SEC 16 T 4 R 19 W
BOOK PAGE 78 LINE 9

OPERATOR Jones, Shelburne & Farmer, Inc.ADDRESS Russell, Kansas

15-147-00118-00-00

FORMATION RECORD

Give detailed description and thickness of all formations drilled through, contents of sand, whether dry, water, oil or gas.

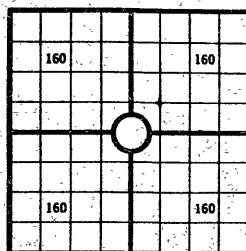640 Acres
N

Locate well correctly

COUNTY Phillips SEC. 16 TWP. 4 RGE. 19
 COMPANY OPERATING Jones, Shelburne & Farmer, Inc.
 OFFICE ADDRESS Russell, Kansas
 FARM NAME Bales WELL NO. 1
 DRILLING STARTED 10/21, 1954 DRILLING FINISHED 11/1, 1954
 DATE OF FIRST PRODUCTION _____ COMPLETED _____
 WELL LOCATED NE 1/4 NE 1/4 SW 1/4 North of South
 Line and _____ ft. East of West Line of Quarter Section
 Elevation (Relative to sea level) DERRICK FLOOR 2006 GROUND _____
 CHARACTER OF WELL (Oil, gas or dryhole) Oil

OIL OR GAS SANDS OR ZONES

Name	From	To	Name	From	To
1			4		
2			5		
3			6		

Perforating Record If Any

Shot Record

Formation	From	To	No. of Shots	Formation	From	To	Size of Shot

CASING RECORD

Amount Set								Amount Pulled		Packer Record	
Size	Wt.	Thds.	Make	Ft.	In.	Ft.	In.	Size	Length	Depth Set	Make
8-5/8				160							
5-1/2				3414							

Liner Record: Amount _____ Kind _____ Top _____ Bottom _____

CEMENTING AND MUDDING

Size	Amount Set		Sacks Cement	Chemical		Method of Cementing	Amount	Mudding Method	Results (See Note)
	Ft.	In.		Gal.	Make				
8-5/8	160		125						
5-1/2	3414		75						

Note: What method was used to protect sands if outer strings were pulled? _____

NOTE: Were bottom hole plugs used? _____ If so, state kind, depth set and results obtained _____

TOOLS USED

Rotary Tools were used from _____ feet to _____ Cable tools were used from _____ feet to _____
 feet, and from _____ feet to _____ feet, and from _____ feet to _____

Type Rig _____

INITIAL PRODUCTION TEST

Describe initial test: whether by flow through tubing or casing or by pumping _____


Amount of Oil Production _____ bbls. Size of choke, if any _____ Length of test _____ Water

Production _____ bbls. Gravity of oil _____ Type of Pump or pump is used, describe _____

I, the undersigned, being first duly sworn upon oath, state that this well record is true, correct and complete according to the records of this office (and to the best of my knowledge and belief).

John D. Farmer Vice-Pres.
 Name and title of representative of company

Subscribed and sworn to before me this 5th day of November, 1954
 My Commission expires 10/11/58
Lucille Kennedy
 Notary Public.

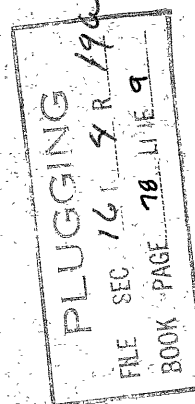

RECEIVED
 STATE CORPORATION COMMISSION
 JAN 24 1955
 CONSERVATION DIVISION
 Wichita, Kansas

TOPS:

Elevation	2008
Heebner	3169
Toronto	3196
Lansing	3212
B/KC	3414
Arbuckle	3592
T.D.	3607

FARM NAME Bales WELL NO. 1 COUNTY Phillips SEC. 16 TWP. 4 RGE. 19