


STATE OF KANSAS  
STATE CORPORATION COMMISSION

15-147-20057-00-00 Form CP-4

Give All Information Completely  
Make Required Affidavit  
Mail or Deliver Report to:  
Conservation Division  
State Corporation Commission  
212 No. Market  
Wichita, Kansas

WELL PLUGGING RECORD

NORTH

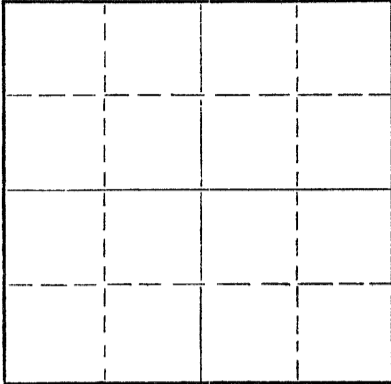

Locate well correctly on above  
Section Plat

Phillips County. Sec. 18 Twp. 4S Rge. 19W (E) W (W)  
Location as "NE/CNW%SW%" or footage from lines C S/2 SW SW  
Lease Owner Mr. Leland Baird  
Lease Name Fischli Well No. 1  
Office Address Logan, Kansas  
Character of Well (completed as Oil, Gas or Dry Hole) D & A  
Date well completed 11-14 19 68  
Application for plugging filed 11-14 19 68  
Application for plugging approved 11-14 19 68  
Plugging commenced 11-14 19 68  
Plugging completed 11-14 19 68  
Reason for abandonment of well or producing formation D & A

If a producing well is abandoned, date of last production 19  
Was permission obtained from the Conservation Division or its agents before plugging was commenced?

Name of Conservation Agent who supervised plugging of this well  
Producing formation Depth to top Bottom Total Depth of Well 3530 Feet  
Show depth and thickness of all water, oil and gas formations.

OIL, GAS OR WATER RECORDS

CASING RECORD

FORMATION	CONTENT	FROM	TO	SIZE	PUT IN	PULLED OUT

Describe in detail the manner in which the well was plugged, indicating where the mud fluid was placed and the method or methods used in introducing it into the hole. If cement or other plugs were used, state the character of same and depth placed, from feet to feet for each plug set.

800' w/70 sxs.  
180' w/20 sxs.  
40' w/ 10 sxs.

RECEIVED  
STATE CORPORATION COMMISSION  
DEC 6 1968  
CONSERVATION DIVISION  
Wichita, Kansas

(If additional description is necessary, use BACK of this sheet)

Name of Plugging Contractor Murfin Drilling Company  
Address 617 Union Center Building, Wichita, Kansas 67202

STATE OF KANSAS, COUNTY OF SEDGWICK, ss.  
James R. Daniels (employee of owner) or (owner or operator) of the above-described well, being first duly sworn on oath, says: That I have knowledge of the facts, statements, and matters herein contained and the log of the above-described well as filed and that the same are true and correct. So help me God.

(Signature) James R Daniels (Address)

Subscribed and sworn to before me this 4th day of Dec, 1968

ADELA MIZENER, Notary Public  
My commission expires November 5, 1970

Notary Public.

WELL LOG

15-147-20057-00-00

COMPANY Mr. Leland Baird

SEC. 18 T. 4S R. 19W

FARM Fischli NO. 1

LOC. C S/2 SW SW

RIG. NO. 8

TOTAL DEPTH 3530


COUNTRY Phillips  
KANSAS

COMM. 11-7-68

COMP. 11-14-68

SHOT OR TREATED

CONTRACTOR ISSUED Murfin Drilling Company

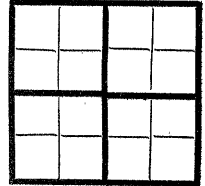

CASING

20 10  
15 8 5/8 w/160 sxs.  
12 6  
13 5

ELEVATION

PRODUCTION Oil

FIGURES INDICATE BOTTOM OF FORMATIONS

70 Post Rock & Shale  
215 Shale  
830 Shale  
1090 Shale  
1270 Sand  
1571 Shale  
1601 Anhydrite  
2180 Shale & Lime  
2415 Shale & Lime  
2650 Lime & Shale  
2870 Shale & Lime  
2906 Shale & Lime  
2978 Shale  
3115 Lime & Shale  
3187 Lime  
3202 Lime & Shale  
3230 Lime  
3250 Lime  
3370 Lime  
3470 Lime  
3530 Lime

RECEIVED  
STATE CORPORATION COMMISSION  
DEC 6 1968  
CONSERVATION DIVISION  
Wichita, Kansas

State of KANSAS  
County of SEDGWICK } ss:

I, James R. Daniels of the Murfin Drilling Company

upon oath state that the above and foregoing is a true and correct copy of the log of the Fischli #1 well.

Subscribed and sworn to before me this 4th day of Dec, 1968

My Commission Expires ADELA MIZENER, Notary Public  
My commission expires November 5, 1970

James R. Daniels  
Adela Mizener  
NOTARY PUBLIC

