

15-147-20062-00-00


WELL PLUGGING RECORD

Give All Information Completely
Make Required Affidavit
Mail or Deliver Report to:
Conservation Division
State Corporation Commission
211 No. Broadway
Wichita, Kansas

Phillips County. Sec. 20 Twp. 4 S Rge. (E) 19 (W)

Location as "NE/CNW/SW" or footage from lines C SW/4 SE/4
Lease Owner The R. W. Rine Drilling Company
Lease Name Reynolds Well No. 2
Office Address Suite 600, 300 W. Douglas, Wichita, Kansas 67202
Character of Well (completed as Oil, Gas or Dry Hole) Dry Hole
Date well completed February 3, 1969 19
Application for plugging filed February 17 19 69
Application for plugging approved (telephone) February 3 19 69
Plugging commenced February 3 19 69
Plugging completed February 3 19 69
Reason for abandonment of well or producing formation Dry

NORTH

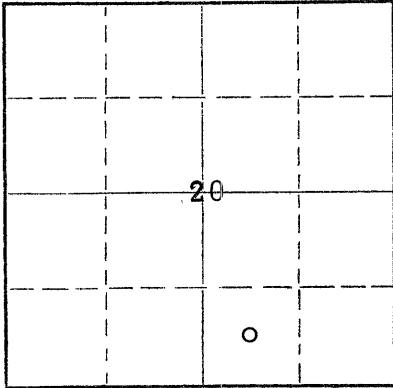

Locate well correctly on above Section Plat

If a producing well is abandoned, date of last production 19
Was permission obtained from the Conservation Division or its agents before plugging was commenced? Yes

Name of Conservation Agent who supervised plugging of this well Leo Massey
Producing formation Lansing-K.C. Depth to top 3210 Bottom Total Depth of Well 3317 Feet
Show depth and thickness of all water, oil and gas formations.

OIL, GAS OR WATER RECORDS

CASING RECORD

FORMATION	CONTENT	FROM	TO	SIZE	PUT IN	PULLED OUT
				8-5/8"	218'	None

Describe in detail the manner in which the well was plugged, indicating where the mud fluid was placed and the method or methods used in introducing it into the hole. If cement or other plugs were used, state the character of same and depth placed, from feet to feet for each plug set.

Heavy mud 3317-800'; Plug at 800', Halliburton spotted 70 sacks cement through open-ended drill pipe; mud to 210'; plug at 210', spotted 20 sacks cement; mud to 40'; plug at 40', spot 1/2 sack cottonseed hulls, then 10 sacks cement to cellar.

RECEIVED
STATE CORPORATION COMMISSION
FEB 18 1969
CONSERVATION DIVISION
Wichita, Kansas
02-18-1969

(If additional description is necessary, use BACK of this sheet)
Name of Plugging Contractor Murfin Drilling Company with Halliburton Services
Address 617 Union Center, Wichita, Kansas 67202

STATE OF KANSAS, COUNTY OF SEDGWICK, ss.
Paul A. Harper (employee of owner) or (owner or operator) of the above-described well, being first duly sworn on oath, says: That I have knowledge of the facts, statements, and matters herein contained and the log of the above-described well as filed and that the same are true and correct. So help me God.

(Signature) Paul A. Harper
Suite 600 - 300 West Douglas - Wichita, Kans.
(Address)

SUBSCRIBED AND SWORN TO before me this 17th day of February, 1969

My commission expires June 8, 1970
Bette J. Edwards Notary Public.

WELL LOG

15-147-20062-00-00

COMPANY R. W. Rine

SEC. 20 T. 4S R. 19W
LOC. C SW SE

FARM Reynolds

NO. 2

RIG. NO. 8

TOTAL DEPTH 3317

COMM. 1/29/69


COMP. 2/4/69

COUNTRY Phillips
KANSAS

SHOT OR TREATED

CONTRACTOR Murfin Drilling Company

ISSUED

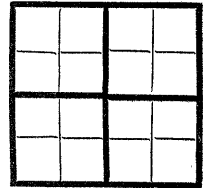

CASING

20	10
15	8 5/8" w/175 sxs.
12	6
13	5

ELEVATION

PRODUCTION D&A

FIGURES INDICATE BOTTOM OF FORMATIONS

180	Sand & clay
219	Shale
390	Shale
1083	Shale
1260	Sand
1465	Shale
1540	Shale-sand
1570	Anhydrite
1805	Shale-shells
2220	Shale-shells
2440	Shale-lime
2640	Shale-lime
2785	Lime & shale
3000	Lime & shale
3120	Shale-lime
3225	Lime
3270	Lime
3310	Lime
3317	RTD

RECEIVED
STATE CORPORATION COMMISSION
MAR 7 1969
CONSERVATION DIVISION
Wichita, Kansas

State of Kansas }
County of Sedgwick } ss:

I, James R. Daniels of the Murfin Drilling Company Company

upon oath state that the above and foregoing is a true and correct copy of the log of the Reynolds #2 well.

Subscribed and sworn to before me this 6th day of March 1969

My Commission Expires: _____

BARBARA KARGES, Notary Public
My Commission expires July 25, 1972

James R. Daniels
Barbara Karges
NOTARY PUBLIC
SEDGWICK COUNTY, KANSAS