


15-137-00095-00-00

WELL PLUGGING RECORD

Give All Information Completely
Make Required Affidavit
Mail or Deliver Report to:
Conservation Division
State Corporation Commission
800 Biting Building
Wichita, Kansas

Norton County. Sec. 36 Twp 4 Rge 22 (E) W (W)
Location as "NE/CNW $\frac{1}{4}$ /SW $\frac{1}{4}$ " or footage from lines SW SW SE
Lease Owner HARRY GORE
Lease Name WALTERS Well No. 1
Office Address 400 Brown Building
Character of Well (completed as Oil, Gas or Dry Hole) Dry Hole
Date well completed 7-11 19 53
Application for plugging filed 7-11 19 53
Application for plugging approved 7-11 19 53
Plugging commenced 7-11 19 53
Plugging completed 7-11 19 53
Reason for abandonment of well or producing formation Dry Hole

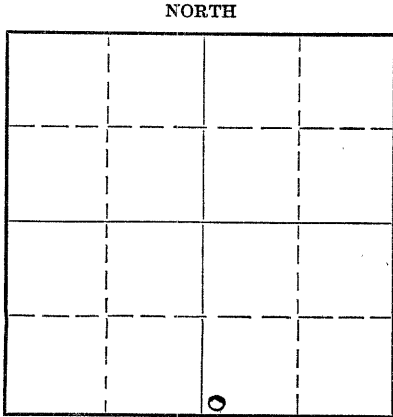

Locate well correctly on above Section Plat

If a producing well is abandoned, date of last production 19...
Was permission obtained from the Conservation Division or its agents before plugging was commenced? yes

Name of Conservation Agent who supervised plugging of this well Eldon Petty
Producing formation Depth to top Bottom Total Depth of Well 3710 Feet
Show depth and thickness of all water, oil and gas formations.

OIL, GAS OR WATER RECORDS

CASING RECORD

Formation	Content	From	To	Size	Put In	Pulled Out
Surface	pipe	0	197	8-5/8	197	0

Describe in detail the manner in which the well was plugged, indicating where the mud fluid was placed and the method or methods used in introducing it into the hole. If cement or other plugs were used, state the character of same and depth placed, from...feet to...feet for each plug set.

Set first plug at 190', 15 sacks of cement.
Set second plug at 40', 10 sacks of cement.

(If additional description is necessary, use BACK of this sheet)

Name of Plugging Contractor EMPIRE DRILLING COMPANY
Address 1121 UNION NAT'L B. BANK BUILDING, WICHITA 2, KANSAS

STATE OF KANSAS, COUNTY OF SEDGWICK, SS.

I, Dan J. Kornfeld, (employee or owner or owner or operator) of the above-described well, being first duly sworn on oath, says: That I have knowledge of the facts, statements, and matters herein contained and the log of the above-described well as filed and that the same are true and correct. So help me God.

(Signature) Dan J. Kornfeld
1121 Union Nat'l Bk. Bldg., Wichita, Ks.
(Address)

SUBSCRIBED AND SWORN to before me this 13 day of July, 19 53

My commission expires 5-5-56

Mary Steinmeier Notary Public.

23-8390-s 6-51-20M

PLUGGING
FILE SEC 36 T 4 R 22 W

746-53

LOG

COMPANY: Harry Gore
 CONTRACTOR: Empire Drilling Company
 FARM: Walters #1
 LOCATION: SW SW SE, Sec. 36-4S-22W
 Norton County, Kansas
 COMMENCED: 7-2-53
 COMPLETED: 7-11-53

0	to	60	Surface Clay
60	to	223	Shale and Shells
223	to	340	Shale
340	to	2230	Shale and Shells
2230	to	2490	Shale and Lime
2490	to	2685	Shale and Shells
2685	to	3125	Shale and Lime
3125	to	3218	Lime
3218	to	3282	Shale and Lime
3282	to	3528	Lime
3528	to	3610	Shale and Lime
3610	to	3670	Shale, Lime and Arbuckle
3670	to	3701	Lime
3701	to	3710	Granite
3710			R.T.D.

ELEVATION - 2183 K.B.

TOPS: Topeka 3178'; Heebner 3330'; Toronto 3354'; Kansas City 3374'; Base of Kansas City 3561' - 1378', Base of Penn. Conglomerate 3619' - 1436'; Arbuckle 3650' - 1467'; Reagan 3670'; Granite 3702'; R.T.D. 3710'.

SCHLUMBERGER: 3707'

Set 197' of 3-5/8" surface Pipe, cemented with 125 sacks of cement.

D&A

CERTIFICATION


I, Dan J. Kornfeld, do hereby certify that the above and foregoing is a true and correct copy of the log of the Walters #1, Section 36, Township 4 South, Range 22 West, Norton County, Kansas, as reflected by the files of the Empire Drilling Company

Dan J. Kornfeld
 Dan J. Kornfeld

Subscribed and sworn to before me a Notary Public within and for Sedgwick County, Kansas, this 13th day of July, 1953.

Mary Hanauer
 NOTARY PUBLIC

My Commission Expires May 5, 1956

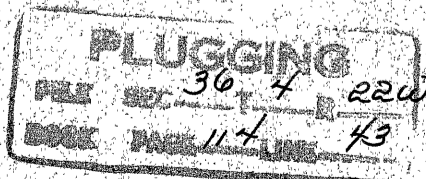

RECEIVED
 STATE COURTS

7-16-53