


Give All Information Completely
Make Required Affidavit
Mail or Deliver Report to:
Conservation Division
State Corporation Commission
212 No. Market
Wichita, Kansas

WELL PLUGGING RECORD

NORTH

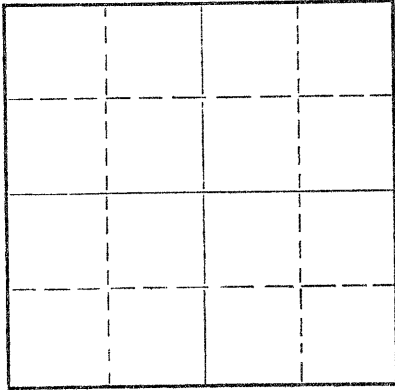

Locate well correctly on above
Section Plat

Norton County. Sec. 34 Twp. 4S Rge. (E) 22 (W)

Location as "NE/CNW/SW" or footage from lines SE SE SE
Lease Owner National Associated Petroleum Co.
Lease Name Elfrade Sanson Well No. 1
Office Address Petroleum Bldg., Tulsa, Oklahoma
Character of Well (completed as Oil, Gas or Dry Hole) D & A
Date well completed 7-5 1968
Application for plugging filed 7-5 1968
Application for plugging approved 7-5 1968
Plugging commenced 7-5 1968
Plugging completed 7-5 1968
Reason for abandonment of well or producing formation _____

If a producing well is abandoned, date of last production _____ 19____
Was permission obtained from the Conservation Division or its agents before plugging was commenced? Yes

Name of Conservation Agent who supervised plugging of this well _____
Producing formation _____ Depth to top _____ Bottom _____ Total Depth of Well _____ Feet
Show depth and thickness of all water, oil and gas formations.

OIL, GAS OR WATER RECORDS				CASING RECORD		
FORMATION	CONTENT	FROM	TO	SIZE	PUT IN	PULLED OUT
				8 5/8"	202'	-0-

Describe in detail the manner in which the well was plugged, indicating where the mud fluid was placed and the method or methods used in introducing it into the hole. If cement or other plugs were used, state the character of same and depth placed, from _____ feet to _____ feet for each plug set.

Mud To 975'
60 Sacks Cement
Mud To 215'
20 Sacks Cement
Mud To 40'
10 Sacks Cement
2 Sacks In Rat Hole

RECEIVED
STATE CORPORATION COMMISSION
JAN 16 1969
CONSERVATION DIVISION
Wichita, Kansas

1-16-69

(If additional description is necessary, use BACK of this sheet)

Name of Plugging Contractor Thoroughbred Drilling Co.
Address Petroleum Bldg., Tulsa, Oklahoma 74103

STATE OF Oklahoma, COUNTY OF Tulsa, ss.
Jack S. Roberts (employee of owner) or (owner or operator) of the above-described well, being first duly sworn on oath, says: That I have knowledge of the facts, statements, and herein contained and the log of the above-described well as filed and that the same are true and correct. So help me God.

(Signature) Jack S. Roberts
Petroleum Bldg., Tulsa, Okla.
(Address)

SUBSCRIBED AND SWORN TO before me this 15th day of January, 1969

My commission expires February 15, 1969
Maple S. Praine Notary Public.

15-137-2008-00-00



Broken Arrow Drilling Company

ROOM 409 PETROLEUM BUILDING • TULSA, OKLAHOMA 74103 • AC 918-582-1181

DRILLER'S LOG

COMPANY: National Associated Petroleum Co.
Petroleum Bldg.
Tulsa, Oklahoma 74103

FARM: Elfrede Sansom **NO. 1**

TOTAL DEPTH 3683

COMM.: 6-24-68 **COMP.:** 7-5-68

CONTRACTOR: Thoroughbred Drilling Co.
Petroleum Bldg.
Tulsa, Oklahoma 74103

SEC. 34 **TWP.** 4s **RGE.** 22w

LOCATION: SE SE SE

COUNTY: Norton

ELEVATION 2183

PRODUCTION: D&A

CASING RECORD: 202' 8 5/8"

CEMENT RECORD: 125 Sacks Cement
200# AC, 200# CC

0 - 200'	Soil
200' - 420'	Shale
420' - 1245'	Shale, Sand & Shale
1245' - 1506'	Shale
1506' - 1800'	Shale & Lime
1800' - 1875'	Anhydrite
1875' - 2335'	Shale
2335' - 3428'	Shale & Lime
3428' - 3578'	Lime
3578' - 3683'	Lime & Sand

RECEIVED
STATE CORPORATION COMMISSION
JAN 16 1969
CONSERVATION DIVISION
Wichita, Kansas
1-16-69

We hereby certify that the above is a true copy of the Driller's Log for the above described well.

BROKEN ARROW DRILLING COMPANY

By:

Jack Roberts
Jack Roberts

Subscribed and sworn to before me this 15 day of January, 1969

My Commission expires: February 21, 1969

Melvin S. Province

Notary Public