


WELL PLUGGING RECORD

Give All Information Completely
Make Required Affidavit
Mail or Deliver Report to:
Conservation Division
State Corporation Commission
800 Bittling Building
Wichita, Kansas

Wiles-Norton County, Sec. 16 Twp. 4 Rge. (E) 22 (W)

Location as "NE/CNW%SW%" or footage from lines SW SW NW
Lease Owner Jones, Shelburne & Farmer, Inc.
Lease Name Wiles Well No. 1
Office Address Russell, Kansas
Character of Well (completed as Oil, Gas or Dry Hole) Dry
Date well completed 5-31 19 54
Application for plugging filed 5-31 19 54
Application for plugging approved 5-31 19 54
Plugging commenced 5-31 19 54
Plugging completed 5-31 19 54
Reason for abandonment of well or producing formation Dry

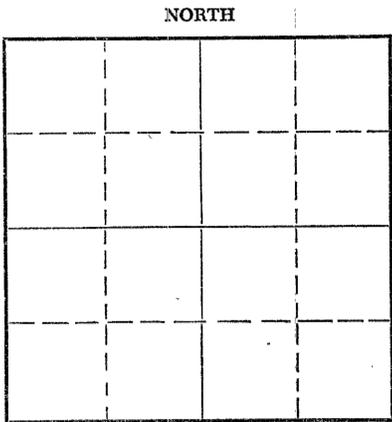

Locate well correctly on above Section Plat

If a producing well is abandoned, date of last production Never produced 19
Was permission obtained from the Conservation Division or its agents before plugging was commenced? yes

Name of Conservation Agent who supervised plugging of this well Eldon Petty
Producing formation Depth to top Bottom Total Depth of Well 3892 Feet
Show depth and thickness of all water, oil and gas formations.


OIL, GAS OR WATER RECORDS

CASING RECORD

FORMATION	CONTENT	FROM	TO	SIZE	PUT IN	PULLED OUT
				8 5/8	230	none

Describe in detail the manner in which the well was plugged, indicating where the mud fluid was placed and the method or methods used in introducing it into the hole. If cement or other plugs were used, state the character of same and depth placed, from feet to feet for each plug set.

1. Filled hole with heavy mud
2. Pushed plug to 230'
3. Dumped 1/2 sack hulls on top of plug
4. Mixed 15 sacks cement and dumped on top of hulls
5. Filled hole to top
6. Pushed plug to 40'
7. Dumped in 1/2 sack hulls
8. Mixed 10 sacks cement and filled hole to top with same

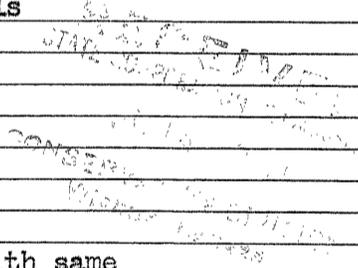


(If additional description is necessary, use BACK of this sheet)
Name of Plugging Contractor Jones, Shelburne & Farmer, Inc.
Address Russell, Kansas

STATE OF Kansas, COUNTY OF Russell, ss.
John O. Farmer (employee of owner) or (owner or operator) of the above-described well, being first duly sworn on oath, says: That I have knowledge of the facts, statements, and matters herein contained and the log of the above-described well as filed and that the same are true and correct. So help me God.

(Signature) John O. Farmer
Russell, Kansas (Address)

SUBSCRIBED AND SWORN TO before me this 2nd day of June, 19 54
Bonnie Deweyhill Notary Public.


My commission expires April 23, 1956

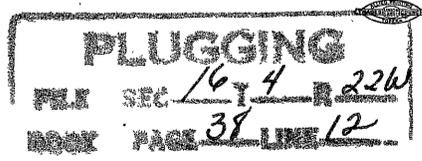

OPERATOR Jones, Shelburne & Farmer, Inc.ADDRESS Russell, Kansas

FORMATION RECORD

Give detailed description and thickness of all formations drilled through, contents of sand, whether dry, water, oil or gas.

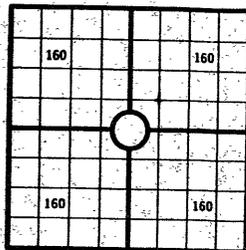640 Acres
N

Locate well correctly

COUNTY Norton SEC 16 TWP 4 RGE 22
 COMPANY OPERATING Jones, Shelburne & Farmer, Inc.
 OFFICE ADDRESS Russell, Kansas
 FARM NAME Wiles WELL NO 1
 DRILLING STARTED 5-22 19 54 DRILLING FINISHED 5-31 19 54
 DATE OF FIRST PRODUCTION _____ COMPLETED _____
 WELL LOCATED SW 1/4 SW 1/4 NW 1/4 North of South
 Line and _____ ft. East of West Line of Quarter Section
 Elevation (Relative to sea level) DERRICK FLOOR 2363 GROUND _____
 CHARACTER OF WELL (Oil, gas or dryhole) Dry

OIL OR GAS SANDS OR ZONES

Name	From	To	Name	From	To
			4		
			5		
			6		

Perforating Record If Any

Shot Record

Formation	From	To	No. of Shots	Formation	From	To	Size of Shot

CASING RECORD

Amount Set						Amount Pulled				Packer Record	
Size	Wt.	Thds.	Make	Ft.	In.	Ft.	In.	Size	Length	Depth Set	Make
8 5/8				230							
5 1/2				none							

Liner Record: Amount _____ Kind _____ Top _____ Bottom _____

CEMENTING AND MUDDING

Size	Amount Set		Sacks Cement	Chemical		Method of Cementing	Amount	Mudding Method	Results (See Note)
	Ft.	In.		Gal.	Make				
8 5/8	230		125						

Note: What method was used to protect sands if outer strings were pulled? _____

NOTE: Were bottom hole plugs used? _____ If so, state kind, depth set and results obtained _____

TOOLS USED

Rotary tools were used from _____ feet to _____ feet to _____ feet, and from _____ feet to _____ feet, and from _____ feet to _____ feet.

Type Rig _____

INITIAL PRODUCTION TEST

Describe initial test: whether by flow through tubing or casing or by pumping _____

Amount of Oil Production _____ bbls. Size of choke, if any _____ Length of test _____ Water
Production _____ bbls. Gravity of oil _____ Type of Pump if pump is used, describe _____

I, the undersigned, being first duly sworn upon oath, state that this well record is true, correct and complete according to the records of this office and to the best of my knowledge and belief.

John W. Farmer, Jr. - Pres.
 Name and title of representative of company

Subscribed and sworn to before me this 2nd day of June, 1954
 My Commission expires April 23, 1956

Donnie Perryhill
 Notary Public

Formation	Top	Bottom	Formation	Top	Bottom
Surface	0	230			
Shale	230	540			
Sand	540	585			
Shale & sand	585	600			
Shale	600	1085			
Shale & sand	1085	1495			
Sand	1495	1750			
Shale & redbed	1750	2017			
Anhydrite	2017	2050			
Shale & shells	2050	2420			
Lime & shale	2420	3566			
Shale & lime	3566	3830			
Sand	3830	3843			
Dolomite	3843	3854			
Sand	3854	3880			
Granite Wash	3880	3885			
Granite	3885	3892			

TOPS:

Elevation 2365 R.B.
 Heebner 3520
 Toronto 3547
 Lansing 3566
 Gorham Sand 3830
 Arbuckle 3843
 Regan 3854
 Granite Wash 3880
 Granite 3885
 T.D. 3892

PLUGGING
 FILE # 161-1-220
 DATE PAGE 38 LINE 12

15137-00123-00-00

FARM NAME Wiles WELL NO. 1 COUNTY Norton SEC. 16 TWP. 4 RGE. 22