

Give All Information Completely
Make Required Affidavit
Mail or Deliver Report to:
Conservation Division
State Corporation Commission
800 Bittling Building
Wichita, Kansas

WELL PLUGGING RECORD

NORTH

Locate well correctly on above
Section Plat

Norton County. Sec. 11 Twp. 4 Rge. (E) 22(W)
Location as "NE/CNW%SW%" or footage from lines SW SE SW
Lease Owner Jones, Shelburne & Farmer, Inc.
Lease Name Fisher Well No. 1
Office Address Russell, Kansas
Character of Well (completed as Oil, Gas or Dry Hole) Dry
Date well completed 5-15 1954
Application for plugging filed 5-15 1954
Application for plugging approved 5-15 1954
Plugging commenced 5-15 1954
Plugging completed 5-15 1954
Reason for abandonment of well or producing formation dry

If a producing well is abandoned, date of last production Never produced 19
Was permission obtained from the Conservation Division or its agents before plugging was commenced? yes

Name of Conservation Agent who supervised plugging of this well Eldon Petty
Producing formation Depth to top Bottom Total Depth of Well 3767 Feet
Show depth and thickness of all water, oil and gas formations.

OIL, GAS OR WATER RECORDS

CASING RECORD

FORMATION	CONTENT	FROM	TO	SIZE	PUT IN	PULLED OUT
				8 5/8	280	none

Describe in detail the manner in which the well was plugged, indicating where the mud fluid was placed and the method or methods used in introducing it into the hole. If cement or other plugs were used, state the character of same and depth placed, from feet to feet for each plug set.

1. Filled hole with heavy mud
2. Pushed plug to 280'
3. Dumped 1/2 sack hulls on top of plug
4. Mixed 15 sacks cement and dumped on top of hulls
5. Filled hole to top
6. Pushed plug to 408'
7. Dumped in 1/2 sack hulls
8. Mixed 10 sacks cement and filled hole to top with same

RECEIVED
STATE CORPORATION COMMISSION
MAY 28 1954
CONSERVATION DIVISION
Wichita, Kansas


(If additional description is necessary, use BACK of this sheet)
Name of Plugging Contractor Jones, Shelburne & Farmer, Inc.
Address Russell, Kansas

STATE OF Kansas, COUNTY OF Russell, ss.
John O. Farmer (employee of owner) or (owner or operator) of the above-described well, being first duly sworn on oath, says: That I have knowledge of the facts, statements, and matters herein contained and the log of the above-described well as filed and that the same are true and correct. So help me God.

(Signature) John O. Farmer
Russell, Kansas (Address)

SUBSCRIBED AND SWORN TO before me this 27th day of May, 19 54
Bonnie Burghill
Notary Public.

My commission expires April 23, 1956

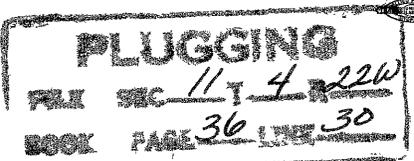


OPERATOR Jones, Shelburne & Farmer, Inc.

FORMATION RECORD

ADDRESS Russell, Kansas

Give detailed description and thickness of all formations drilled through, contents of sand, whether dry, water, oil or gas.

FARM NAME Fisher COUNTY Norton WELL NO. 11 TWP. 4 SEC. 11 RGE. 22

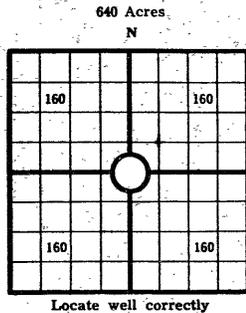

COUNTY Norton SEC. 11 TWP. 4 RGE. 22
 COMPANY OPERATING Jones, Shelburne & Farmer, Inc.
 OFFICE ADDRESS Russell, Kansas
 FARM NAME Fisher WELL NO. 11
 DRILLING STARTED 5-13-54 DRILLING FINISHED 5-19-54
 DATE OF FIRST PRODUCTION COMPLETED
 WELL LOCATED SW 1/4 SE 1/4 SW 1/4 North of South
 Line and _____ ft. East of West Line of Quarter Section
 Elevation (Relative to sea level) DERRICK FLOOR 2236 GROUND _____
 CHARACTER OF WELL (Oil, gas or dryhole) Dry

OIL OR GAS SANDS OR ZONES

Name	From	To	Name	From	To
1			4		
2			5		
3			6		

Perforating Record If Any

Shot Record

Formation	From	To	No. of Shots	Formation	From	To	Size of Shot

CASING RECORD

Amount Set						Amount Pulled		Packer Record	
Size	Wt.	Thds.	Make	Ft.	In.	Size	Length	Depth Set	Make
8 5/8				280					
5 XXX/2									

Liner Record: Amount _____ Kind _____ Top _____ Bottom _____

CEMENTING AND MUDDING

Size	Amount Set		Sacks Cement	Chemical		Method of Cementing	Amount	Mudding Method	Results (See Note)
	Ft.	In.		Gal.	Make				
8 5/8	280		125						

Note: What method was used to protect sands if outer strings were pulled? _____

NOTE: Were bottom hole plugs used? _____ If so, state kind, depth set and results obtained _____

TOOLS USED

Rotary Tools were used from _____ feet to _____ feet to _____ feet, and from _____ feet to _____ feet, and from _____ feet to _____ feet.

Type Rig _____

INITIAL PRODUCTION TEST

Describe initial test: whether by flow through tubing or casing or by pumping _____

Amount of Oil Production _____ bbls. Size of choke, if any _____ Length of test _____ Water

Production _____ bbls. Gravity of oil _____ Type of Pump or pump is used, describe _____

Formation	Top	Bottom	Formation	Top	Bottom
Surface	0	165			
Shale	165	900			
Sand	900	1000			
Shale & sand	1000	1430			
Sand	1430	1610			
Shale & redbed	1610	1903			
Anhydrite	1903	1933			
Shale & shells	1933	2380			
Lime & shale	2380	3460			
Lime	3460	3668			
Conglomerate	3668	3757			
Dolomite	3757	3767			

RECEIVED
 STATE CORPORATION COMMISSION
 MAY 28 1954
 CONSERVATION DIVISION
 Wichita, Kansas
 5-28-54
 15-137-00124-00-00

TOPS:

Elevation 2238 R.B.
 Heebaer 3428
 Lansing 3475
 Base K.C. 3668
 Cong. 3730
 Arbuckle 3757
 T.D. 3767

PLUGGING
 MAY 11 1954
 PAGE 36 LINE 30

I, the undersigned, being first duly sworn upon oath, state that this well record is true, correct and complete according to the records of this office and to the best of my knowledge and belief.

John D. Farmer Vice-Pres.
 Name and title of representative of company

Subscribed and sworn to before me this 20th day of May 1954
 My Commission expires April 23, 1956
 Bonnie Berryhill
 Notary Public