

This form shall be filed in duplicate with the Kansas Corporation Commission, 200 Colorado Derby Building, Wichita, Kansas 67202, within ten days after the completion of the well, regardless of how the well was completed.

Attach separate letter of request if the information is to be held confidential. If confidential, only file one copy. Information on side one will be of public record and side two will then be held confidential.

Circle one: Oil, Gas, Dry, SWD, OWO, Injection. Type and complete ALL sections. Applications must be filed for dual completion, commingling, SWD and injection, T.A.

Attach wireline logs (i.e. electrical log, sonic log, gamma ray neutron log, etc.). KCC # (316) 263-3238. (Rules 82-2-105 & 82-2-125)

OPERATOR Baird Oil Co., Inc.

API NO. 15-147-20,282-00-00

ADDRESS Box 428

COUNTY Phillips

Logan, Kansas, 67646

FIELD Slinker

\*\*CONTACT PERSON Jim R. Baird

PROD. FORMATION K. C.

PHONE (913) 689-7456

LEASE Donahey

PURCHASER C. R. A. Inc.

WELL NO. #1

ADDRESS P.O. Box 7305

WELL LOCATION NE SW

Kansas City, Mo., 64116

660 Ft S from North Line and

DRILLING Abercrombie Drilling, Inc.

CONTRACTOR

ADDRESS 801 Union Center

400 Ft W from east Line of

Wichita, Ks. 67202


the NE SW SEC. 25 TWP. 4S RGE. 20W

PLUGGING

CONTRACTOR

ADDRESS

WELL PLAT

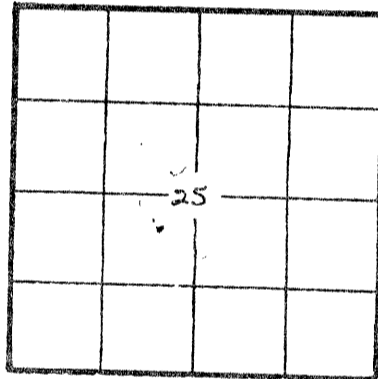

KCC [check] KGS [check] (Office Use)

TOTAL DEPTH 3440' PBDT

SPUD DATE 8-11-80 DATE COMPLETED 9-25-80

ELEV: GR 1963 DF KB 1968

DRILLED WITH (CABLE) (ROTARY) (AIR) TOOLS

Amount of surface pipe set and cemented 215' DV Tool Used? no

AFFIDAVIT

STATE OF Kansas, COUNTY OF Phillips SS, I,

Jim R. Baird OF LAWFUL AGE, BEING FIRST DULY SWORN UPON HIS OATH, DEPOSES THAT HE IS Vice-President (FOR) OF Baird Oil Co., Inc.

OPERATOR OF THE Donahey LEASE, AND IS DULY AUTHORIZED TO MAKE

THIS AFFIDAVIT FOR AND ON THE BEHALF OF SAID OPERATOR, THAT WELL NO. #1 ON SAID LEASE HAS BEEN COMPLETED AS OF THE 25th DAY OF September, 19 80, AND THAT

ALL INFORMATION ENTERED HEREIN WITH RESPECT TO SAID WELL IS TRUE AND CORRECT.

STATE CORP. COMMISSION RECEIVED NOT. FURTHER AFFIDAVIT REQUIRED

JUL 23 1982

SUBSCRIBED AND SWORN BEFORE ME THIS 21st DAY OF July, 19 82

CONSERVATION DIVISION Wichita, Kansas

MARILYN J. ALLEN NOTARY PUBLIC STATE OF KANSAS MY APPT. EXPIRES 2-9-86

NOTARY PUBLIC

MY COMMISSION EXPIRES: 2-9-86

\*\*The person who can be reached by phone regarding any questions concerning this information. Within 45 days of completion, a witnessed initial test by the Commission is required if the well produces more than 25 BOPD or is located in a Basic Order Pool.