

15-039-19008-00-00


STATE OF KANSAS  
STATE CORPORATION COMMISSION

Give All Information Completely  
Make Required Affidavit  
Mail or Deliver Report to:  
Conservation Division  
State Corporation Commission  
211 No. Broadway  
Wichita, Kansas

WELL PLUGGING RECORD

Decatur County. Sec. 26 Twp. 4S Rge. (E) 27 (W)

Location as "NE/CNW/SW" or footage from lines SE NE SE  
Lease Owner Peel-Hardman Oil Operators  
Lease Name Nellans Well No. 1  
Office Address R. R. #3, Box 144B, Wichita, Kansas  
Character of Well (completed as Oil, Gas or Dry Hole) Dry hole  
Date well completed Sept. 20, 19 56  
Application for plugging filed October 2, 19 56  
Application for plugging approved October 2, 19 56  
Plugging commenced October 2, 19 56  
Plugging completed October 4, 19 56  
Reason for abandonment of well or producing formation Dry hole

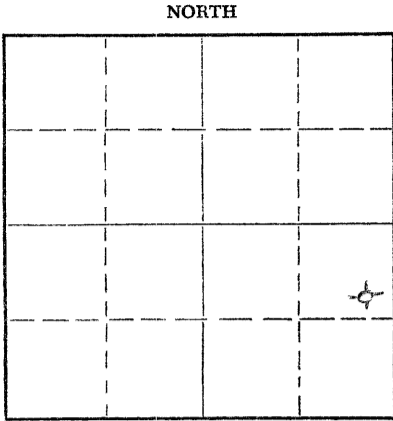

Locate well correctly on above Section Plat

If a producing well is abandoned, date of last production \_\_\_\_\_ 19\_\_\_\_  
Was permission obtained from the Conservation Division or its agents before plugging was commenced? Yes

Name of Conservation Agent who supervised plugging of this well Eldon Petty  
Producing formation \_\_\_\_\_ Depth to top \_\_\_\_\_ Bottom \_\_\_\_\_ Total Depth of Well 3542 Feet  
Show depth and thickness of all water, oil and gas formations.

OIL, GAS OR WATER RECORDS

CASING RECORD

| FORMATION | CONTENT | FROM | TO       | SIZE   | PUT IN   | PULLED OUT |
|-----------|---------|------|----------|--------|----------|------------|
|           |         | 0    | 262 1/2' | 8 5/8" | 262 1/2' | None       |
|           |         | 0    | 3524'    | 5 1/2" | 3524'    | 2516'      |
|           |         |      |          |        |          |            |
|           |         |      |          |        |          |            |
Describe in detail the manner in which the well was plugged, indicating where the mud fluid was placed and the method or methods used in introducing it into the hole. If cement or other plugs were used, state the character of same and depth placed, from \_\_\_\_\_ feet to \_\_\_\_\_ feet for each plug set.

Dumped 4 sacks cement at the bottom of hole. Shot pipe off at 2516'. Pulled pipe and mudded hole to 300'. Set rock bridge and dumped 25 sacks of cement at 300'. Finished mudding hole and put 10 sacks of cement at base of cellar.

(If additional description is necessary, use BACK of this sheet)  
Name of Plugging Contractor Bert Self  
Address R. R. #4, Hutchinson, Kansas

STATE OF KANSAS, COUNTY OF BARTON, ss.  
William Herbert (employee of owner) or owner/operator of the above-described well, being first duly sworn on oath, says: That I have knowledge of the facts, statements, and matters herein contained and the log of the above-described well as filed and that the same are true and correct. So help me God.

(Signature) William Herbert  
R. R. #3, Box 144B, Wichita, Kansas (Address)

SUBSCRIBED AND SWORN TO before me this 19th day of November, 19 56

My commission expires June 4, 1959. Marian Herbert Notary Public.

PLUGGING  
FILE SEC. 26 T. 4 R. 27W  
BOOK PAGE 104 LINE 19

RECEIVED  
STATE CORPORATION COMMISSION  
NOV 20 1956  
CONSERVATION DIVISION  
Wichita, Kansas  
11-20-56