


15-039-00104-00-00

STATE OF KANSAS  
STATE CORPORATION COMMISSION

WELL PLUGGING RECORD

Give All Information Completely  
Make Required Affidavit  
Mail or Deliver Report to:  
Conservation Division  
State Corporation Commission  
800 Biting Building  
Wichita, Kansas

NORTH

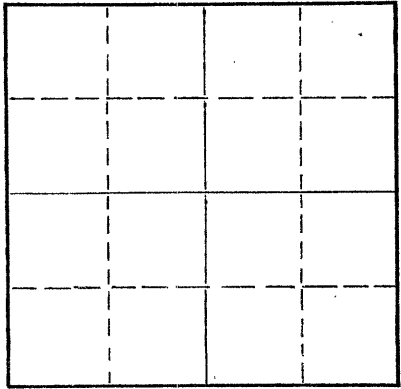

Locate well correctly on above  
Section Plat

Decatur County. Sec. 3 Twp. 4 Rge.      (E) 29 (W)  
Location as "NE/CNW/SW" or footage from lines SW SW SE  
Lease Owner Jones, Shelburne & Farmer, Inc.  
Lease Name Wymore Well No. 1  
Office Address Russell, Kansas  
Character of Well (completed as Oil, Gas or Dry Hole) Dry  
Date well completed 4-13 1955  
Application for plugging filed 4-13 1955  
Application for plugging approved 4-13 1955  
Plugging commenced 4-13 1955  
Plugging completed 4-13 1955  
Reason for abandonment of well or producing formation Dry

If a producing well is abandoned, date of last production      19      
Was permission obtained from the Conservation Division or its agents before plugging was commenced? Yes

Name of Conservation Agent who supervised plugging of this well Eldon Petty  
Producing formation      Depth to top      Bottom      Total Depth of Well 4665 Feet  
Show depth and thickness of all water, oil and gas formations.

| OIL, GAS OR WATER RECORDS |         |      |    | CASING RECORD |        |            |
|---------------------------|---------|------|----|---------------|--------|------------|
| FORMATION                 | CONTENT | FROM | TO | SIZE          | PUT IN | PULLED OUT |
|                           |         |      |    | 8-5/8         | 225'   | None       |
|                           |         |      |    |               |        |            |
|                           |         |      |    |               |        |            |
Describe in detail the manner in which the well was plugged, indicating where the mud fluid was placed and the method or methods used in introducing it into the hole. If cement or other plugs were used, state the character of same and depth placed, from      feet to      feet for each plug set.

1. Filled hole with heavy mud
2. Pushed plug to 225'
3. Dumped 1/2 sack hulls on top of plug
4. Mixed 15 sacks cement and dumped on top of hulls
5. Filled hole to top
6. Pushed plug to 40'
7. Dumped in 1/2 sacks hulls
8. Mixed 10 sacks cement and filled hole to top with same.

(If additional description is necessary, use BACK of this sheet)  
Name of Plugging Contractor Jones, Shelburne & Farmer, Inc.  
Address Russell, Kansas

STATE OF Kansas, COUNTY OF Russell, ss.  
John O. Farmer (employee of owner) or (owner or operator) of the above-described well, being first duly sworn on oath, says: That I have knowledge of the facts, statements, and matters herein contained and the log of the above-described well as filed and that the same are true and correct. So help me God.

(Signature) John O. Farmer  
Russell, Kansas (Address)

SUBSCRIBED AND SWORN to before me this 19th day of April, 1955

My commission expires October 11, 1958  
Lucille Kennedy Notary Public.

PLUGGING  
FILE SEC 3 T 4 R 29W  
BOOK 112 LINE 12

RECEIVED  
STATE CORPORATION COMMISSION  
APR 20 1955  
420-55  
CONSERVATION DIVISION  
Wichita, Kansas