


STATE OF KANSAS
STATE CORPORATION COMMISSION

WELL PLUGGING RECORD

Give All Information Completely
Make Required Affidavit
Mail or Deliver Report to
Conservation Division
State Corporation Comm.
245 North Water
Wichita, KS 67202

Decatur County. Sec. 32 Twp. 4S Rge. 29W $\frac{1}{4}$ NW
Location as "NE/CNW $\frac{1}{4}$ SW $\frac{1}{4}$ " or footage from lines
SW NE SE

Lease Owner F & M OIL CO., INC.
Lease Name Summit Well No. 1
Office Address 422 Union Center, Wichita, Ks. 67202
Character of Well (Completed as Oil, Gas or Dry Hole)

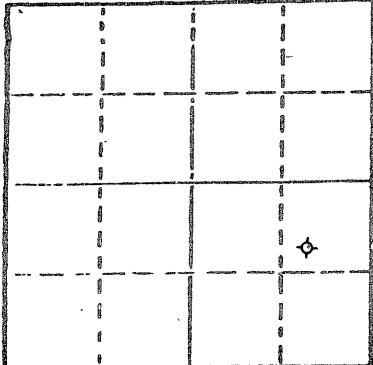

Locate well correctly on above
Section Plot

Dry
Date Well completed September 4, 1982
Application for plugging filed September 4, 1982
Application for plugging approved September 4, 1982
Plugging commenced September 4, 1982
Plugging completed September 4, 1982
Reason for abandonment of well or producing formation

Dry
If a producing well is abandoned, date of last production 19

Was permission obtained from the Conservation Division or
its agents before plugging was commenced? Yes

Name of Conservation Agent who supervised plugging of this well Carl Goodrow
Producing formation _____ Depth to top _____ Bottom _____ Total Depth of Well 3945'
Show depth and thickness of all water, oil and gas formations.

OIL, GAS OR WATER RECORDS

CASING RECORD

FORMATION	CONTENT	FROM	TO	SIZE	PUT IN	PULLED OUT

Describe in detail the manner in which the well was plugged, indicating where the mud fluid
was placed and the method or methods used in introducing it into the hold. If cement or other
plugs were used, state the character of same and depth placed, from _____ feet to
_____ feet for each plug set.

Set 1st plug @ 850' w/100 sxs
Set 2nd plug @ 275' w/40 sxs
Set 3rd plug @ 40' w/10 sxs
10 sxs in the rat hole , 10 sxs in the water well
plug down @ 5 am 9-4-82

(If additional description is necessary, use BACK of this sheet)

Name of Plugging Contractor Union Drilling Co., Inc.

STATE OF Kansas COUNTY OF Sedgwick, ss.
R. D. Messinger (employee of owner) or (owner or operator)
of the above-described well, being first duly sworn on oath, says: That I have knowledge of
the facts, statements, and matters herein contained and the log of the above-described well
as filed and that the same are true and correct. So help me God.

(Signature) R. D. Messinger
422 Union Center, Wichita, Kansas 67202
(Address)

SUBSCRIBED AND SWORN TO before me this 9th day of September, 1982

Shirley A. Gallegos
Shirley A. Gallegos Notary Public.

My commission expires 12-24-84



RECEIVED
STATE CORPORATION COMMISSION

SEP 15 1982

CONSERVATION DIVISION
Wichita, Kansas

9-15-82