


STATE OF KANSAS
STATE CORPORATION COMMISSION

WELL PLUGGING RECORD

Give All Information Completely
Make Required Affidavit
Mail or Deliver Report to
Conservation Division
State Corporation Comm.
245 North Water
Wichita, KS 67202

Rawlins County. Sec. 14 Twp. 4 Rge. 33 W
Location as "NE/CNW/SW" or footage from lines
S 1/2 - SE - NE 14-4-33
Lease Owner Ryda Exploration
Lease Name Ken Ryda Well No. J
Office Address RR1 Box 87, Atwood, KS
Character of Well (Completed as Oil, Gas or Dry Hole) _____

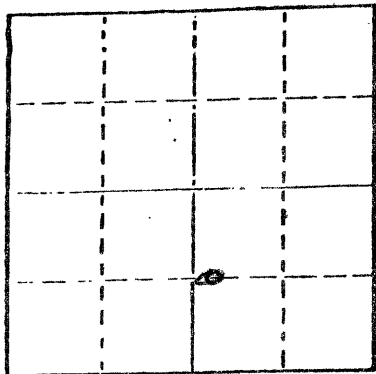

Locate well correctly on above
Section Plot

Date Well completed 1-16 1979
Application for plugging filed Jan 1989
Application for plugging approved _____ 19____
Plugging commenced 4-5- 1989
Plugging completed 4-6- 1989
Reason for abandonment of well or producing formation
NO GAS
If a producing well is abandoned, date of last production _____ 19____

Was permission obtained from the Conservation Division or its agents before plugging was commenced? Yes

Name of Conservation Agent who supervised plugging of this well Carl Goodrow
Producing formation _____ Depth to top _____ Bottom _____ Total Depth of Well 785
Show depth and thickness of all water, oil and gas formations.

OIL, GAS OR WATER RECORDS

CASING RECORD

FORMATION	CONTENT	FROM	TO	SIZE	PUT IN	PULLED OUT
<u>Ogallala</u>	<u>Water</u>	<u>60</u>	<u>120</u>	<u>5 1/2</u>	<u>168</u>	<u>None</u>

Describe in detail the manner in which the well was plugged, indicating where the mud fluid was placed and the method or methods used in introducing it into the hold. If cement or other plugs were used, state the character of same and depth placed, from _____ feet to _____ feet for each plug set.

2 SKS hulls with 65 SKS cement tied onto 5 1/2 CS9 mixed max pressure on shut in at 200 #

APR 13 1989

CONSERVATION DIVISION
Wichita, Kansas

4-18-89

(If additional description is necessary, use BACK of this sheet)

Name of Plugging Contractor ALLIED Cont.

STATE OF _____ COUNTY OF _____, ss.

(employee of owner) or (owner or operator)
of the above-described well, being first duly sworn on oath, says: That I have knowledge of the facts, statements, and matters herein contained and the log of the above-described well as filed and that the same are true and correct. So help me God.

(Signature) [Signature]
RR1 Box 87 Atwood
(Address)

SUBSCRIBED AND SWORN TO before me this 11 day of April, 1989

Connie Adams
Notary Public.

My commission expires 5-1-93