15-153-00004-00-00


STATE OF KANSAS
STATE CORPORATION COMMISSION

Form CP-4

Give All Information Completely
Make Required Affidavit
Mail or Deliver Report to:
Conservation Division
State Corporation Commission
212 No. Market
Wichita, Kansas

WELL PLUGGING RECORD

NORTH

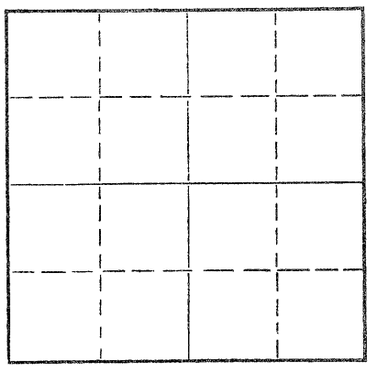

Locate well correctly on above Section Plat

Rawlins County. Sec. 14 Twp. 3 Rge. 33W (E) (W)

Location as "NE/CNW¼SW¼" or footage from lines C NE SW

Lease Owner Jackson, Shear & Parker

Lease Name Ruda Well No. 1

Office Address Box 149 Duncan, Oklahoma

Character of Well (completed as Oil, Gas or Dry Hole) depleted-oil DH

Date well completed 19

Application for plugging filed 19

Application for plugging approved 19

Plugging commenced 19

Plugging completed September 4, 19 58

Reason for abandonment of well or producing formation

If a producing well is abandoned, date of last production 19

Was permission obtained from the Conservation Division or its agents before plugging was commenced? yes

Name of Conservation Agent who supervised plugging of this well A. D. Fabricius

Producing formation Depth to top Bottom Total Depth of Well 4680 Feet

Show depth and thickness of all water, oil and gas formations.

OIL, GAS OR WATER RECORDS — CASING RECORD

FORMATION	CONTENT	FROM	TO	SIZE	PUT IN	PULLED OUT

Describe in detail the manner in which the well was plugged, indicating where the mud fluid was placed and the method or methods used in introducing it into the hole. If cement or other plugs were used, state the character of same and depth placed, from feet to feet for each plug set.

Sanded back to 3935' - 4 sacks cement by dump bailer
mudded back to 280' -10' rock bridge - 20 sacks cement
Mudded backto 40' - 10' rock bridge & 10 sacks cement
to base of cellar. 288' of 8 5/8" surface casing.

RECEIVED
STATE CORPORATION COMMISSION
MAR 24 1966
CONSERVATION DIVISION
Wichita, Kansas

3-24-66

(If additional description is necessary, use BACK of this sheet)

Name of Plugging Contractor Barnes & Sons

Address Russell, Kansas

STATE OF Kansas, COUNTY OF Russell, ss.

(employee of owner) or (owner or operator) of the above-described well, being first duly sworn on oath, says: That I have knowledge of the facts, statements, and matters herein contained and the log of the above-described well as filed and that the same are true and correct. So help me God.

(Signature) Bob Barnes

P.O.Box 313 Russell, Kansas
(Address)

SUBSCRIBED AND SWORN TO before me this 22nd day of March, 1966

My commission expires December 4, 1969

Notary Public.