


Give All Information Completely  
Make Required Affidavit  
Mail or Deliver Report to:  
Conservation Division  
State Corporation Commission  
212 North Market, Insurance Bldg.  
Wichita, Kansas

15-153-05172-00-00

WELL PLUGGING RECORD

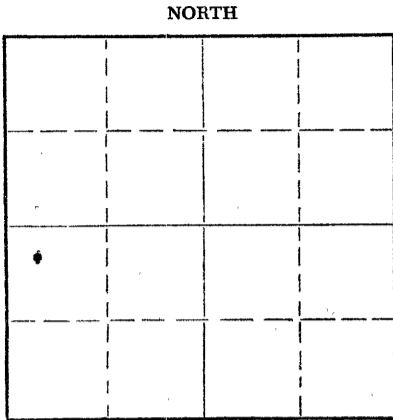

Locate well correctly on above Section Plat

Rawlins County. Sec. 17 Twp. 4S Rge. (E) 33 (W)  
Location as "NE/CNW/SW" or footage from lines NW-NW-SW  
Lease Owner Amerada Petroleum Corporation  
Lease Name R.W. Walters Tract 1 Well No. 2  
Office Address Box 197, Great Bend, Kansas  
Character of Well (completed as Oil, Gas or Dry Hole) \_\_\_\_\_  
Date well completed 1-6- 1960  
Application for plugging filed 1-6- 1960  
Application for plugging approved 1-6- 1960  
Plugging commenced 12 Noon 1-6- 1960  
Plugging completed 1:45 p.m. 1-6- 1960  
Reason for abandonment of well or producing formation Dry Hole

If a producing well is abandoned, date of last production \_\_\_\_\_ 19\_\_\_\_  
Was permission obtained from the Conservation Division or its agents before plugging was commenced? Yes

Name of Conservation Agent who supervised plugging of this well A.D. Fabricius, Hill City, Kansas  
Producing formation None Depth to top \_\_\_\_\_ Bottom \_\_\_\_\_ Total Depth of Well 4280' Feet  
Show depth and thickness of all water, oil and gas formations.

OIL, GAS OR WATER RECORDS

CASING RECORD

FORMATION	CONTENT	FROM	TO	SIZE	PUT IN	PULLED OUT
				8-5/8"	316'	None

Describe in detail the manner in which the well was plugged, indicating where the mud fluid was placed and the method or methods used in introducing it into the hole. If cement or other plugs were used, state the character of same and depth placed, from \_\_\_\_\_ feet to \_\_\_\_\_ feet for each plug set.

Halliburton Spotted Cement Plugs Thru 4-1/2" Drill Pipe As Follows:  
500' to 440' W/20 Sacks Cement  
300' to 240' W/20 " "  
50' to Top W/16 " "

RECEIVED  
STATE CORPORATION COMMISSION

JAN 11 1960

CONSERVATION DIVISION  
Wichita, Kansas

1-11-60

(If additional description is necessary, use BACK of this sheet)  
Name of Plugging Contractor Amerada Petroleum Corporation  
Address Box 197, Great Bend, Kansas

STATE OF Kansas, COUNTY OF Barton, ss.  
Ernest Higgins (employee of owner) or (owner or operator) of the above-described well, being first duly sworn on oath, says: That I have knowledge of the facts, statements, and matters herein contained and the log of the above-described well as filed and that the same are true and correct. So help me God.

(Signature) Ernest Higgins

SUBSCRIBED AND SWORN TO before me this 7th day of January, 1960

My commission expires November 21, 1961 Notary Public.

