
KANSAS

J. P. Roberts Administrator 500 Insurance Building Wichita, Kansas 67202

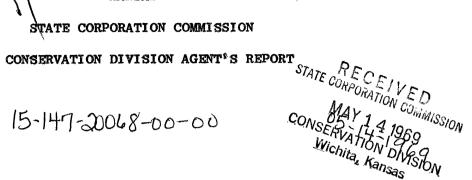

Operator's Full Name Petroleum Management, Inc.	
Complete Address: Box 922 Grea	t Bend, Kansas 67530
Lease Name White	Well No. 1
Location NE NW NE	Sec. 19 Twp. 4 Rge. 19 (E) (W) XX
County Phillips	Total Depth 3399
Abandoned Oil Well XX Gas Well In	put Well D & A
Other well as hereafter indicated:	
Plugging Contractor: Southwest Casing Pulling	
Address: Box 364	Great Bend, Kansas License No. 399
Operation Completed: Hour 11A Day	12 Month 5 Year 1969
The Above well was plugged as follows:	
Total Depth 3399 8 5/8 csg set at 222 cwc 145 sk.	
4½ csg set at 3399 cw 225 sk cmt.	
$4\frac{1}{2}$ csg perf. (3201-3248)	
Filled $4\frac{1}{2}$ csg W/sd (3180-3399) Dumped 4 sk cmt W/dump bailer. (3140-3180)	
Shotoff and recovered 2284 of 42 csg.	
Pumped thru 8 5/8 plug container with 20 s	k gel, 100 lbs hulls, 130 sk 50-50 poz cmt
6% total gel, 4 sk gel W/100 lbs hulls,Plu	g and 10 sk cmt. Max. pres. 400 lbs. SI 250 lbs
Cmt. (0-40) gel (40-200) Cmt (200-800) Gel	• (800TD)
I hereby certify that the above well was plugged as herein stated.	
	Signed: But 7. Wasser
IIVQIÇED	Well Plugging Supervisor
DATE	
INV. NO. 9941-W	