

CARD MUST BE TYPED

State of Kansas  
**NOTICE OF INTENTION TO DRILL**  
(see rules on reverse side)

CARD MUST BE SIGNED

Starting Date: 10/15/84  
month day year

API Number 15- 039-20,085-400-01

OPERATOR: License # 5198  
Name A. Scott Ritchie  
Address 125 N. Market, Suite 950  
City/State/Zip Wichita, Kansas 67202  
Contact Person Leah Ann Kasten  
Phone 316/267-4375

. C. NE. NE. Sec 23. Twp. 4. S, Rge. 27  East  West  
(location)

4620 Ft North from Southeast Corner of Section  
660 Ft West from Southeast Corner of Section  
(Note: Locate well on Section Plat on reverse side)

CONTRACTOR: License # 6033  
Name Murfin Drilling Co.  
City/State Wichita, Kansas

Nearest lease or unit boundary line 660 feet.  
County Decatur  
Lease Name Petracek OWO Well# 4

Domestic well within 330 feet:  yes  no  
Municipal well within one mile:  yes  no

Well Drilled For: Well Class: Type Equipment:  
 Oil  Swd  Infield  Mud Rotary  
 Gas  Inj  Pool Ext.  Air Rotary  
 OWWO  Expl  Wildcat  Cable

Depth to Bottom of fresh water 100 feet  
Lowest usable water formation Dakota  
Depth to Bottom of usable water 1300 feet  
Surface pipe by Alternate: 1  2   
Surface pipe to be set 242' feet  
Conductor pipe if any required feet  
Ground surface elevation 2553 feet MSL  
This Authorization Expires 4-5-85  
Approved By 10-15-84

If OWWO: old well info as follows:

Operator Murfin Drlg. Co. & Nadel & Gussman  
Well Name #1 Petracek  
Comp Date 5/08/69 Old Total Depth 3925  
Projected Total Depth 3925 feet  
Projected Formation at TD Arbuckle  
Expected Producing Formations Lansing

I certify that we will comply with K.S.A. 55-101, et seq., plus eventually plugging hole to K.C.C. specifications.

Date 10/02/84 Signature of Operator or Agent Leah Ann Kasten Title Geologist


Form C-1 4/84

MHC/UDHE 10/5/84

**Must be filed with the K.C.C. five (5) days prior to commencing well  
This card void if drilling not started within six (6) months of date received by K.C.C.**

STATE OF KANSAS  
10-5-84  
OCT 05 1984

**A Regular Section of Land  
1 Mile = 5,280 Ft.**

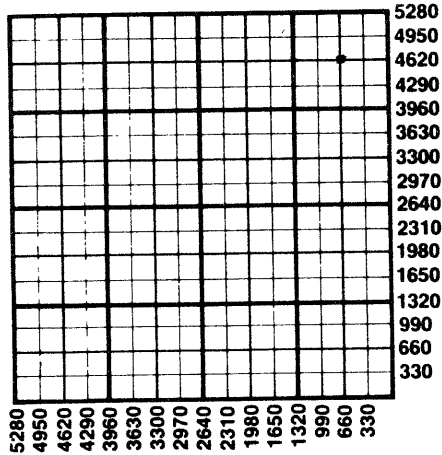

- Important procedures to follow:**
1. Notify District office before setting surface casing.
  2. Set surface casing by circulating cement to the top.
  3. File completion forms ACO-1 with K.C.C. within 90 days of well completion, following instructions on ACO-1, side 1, and including copies of wireline logs.
  4. Notify District office 48 hours prior to old well workover or re-entry.
  5. Prior to plugging, prepare a plugging plan, then obtain agreement from the appropriate district office for an approved plugging plan.
  6. Submit plugging report (CP-4) to K.C.C. after plugging is completed.
  7. Obtain an approved injection docket number before disposing of salt water.
  8. Notify K.C.C. within 10 days when injection commences or terminates.
  9. If an alternate 2 completion, cement in the production pipe from below any usable water to surface within 120 days of spud date.

**State Corporation Commission of Kansas  
Conservation Division  
200 Colorado Derby Building  
Wichita, Kansas 67202  
(316) 263-3238**