

CARD MUST BE TYPED

State of Kansas

CARD MUST BE SIGNED

### NOTICE OF INTENTION TO DRILL

(see rules on reverse side)

Expected Spud Date..... 11 14 87  
month day year

API Number 15— 039-20,823-00-00 ✓

OPERATOR: License # 6467  
Name West Kansas Oil Corporation  
Address RR #1, Box 77  
City/State/Zip Selden, Kansas 67757  
Contact Person Charles Young  
Phone 913-475-2766

NE NW SE Sec. 18 Twp. 4 S, Rg. 30W X East  
2310 Ft. from South Line of Section  
1530 Ft. from East Line of Section

CONTRACTOR: License # 5302  
Name Red Tiger Drilling CO.  
City/State Wichita, Kansas 67202

(Note: Locate well on Section Plat on reverse side)  
Nearest lease or unit boundary line 1530 feet  
County Decatur  
Lease Name Leake Well # 1

Well Drilled For: Well Class: Type Equipment:  
 Oil  Storage  Infield  Mud Rotary  
 Gas  Inj  Pool Ext.  Air Rotary  
 OWWO  Expl  Wildcat  Cable

Ground surface elevation 2857 feet MSL  
Domestic well within 330 feet:  yes  no  
Municipal well within one mile:  yes  no

If OWWO: old well info as follows:

Operator .....  
Well Name .....  
Comp Date ..... Old Total Depth .....

Depth to bottom of fresh water 150  
Depth to bottom of usable water 180  
Surface pipe by Alternate: 1 2  
Surface pipe planned to be set 290

I certify that well will comply with K.S.A. 55-101, et seq., plus any rules promulgated by the Board of Geology, by plugging hole to KCC specifications.  
Date 11-9-87 Signature of Operator or Agent

Conductor pipe required N/A  
Projected Total Depth 4500 feet  
Formation Missouri

For KCC Use:  
Conductor Pipe Required ..... feet; Minimum Surface Pipe Required 5-9-88  
This Authorization Expires 5-9-88

BY RED TIGER DRILLING CO.

Title owner  
Approved By RA 11-9-87 200 feet per Alt 1 OX


EFFECTIVE DATE: 11-14-87

Must be filed with the K.C.C. five (5) days prior to commencing well  
 This card void if drilling not started within six (6) months of date received by K.C.C.

**Important procedures to follow:**

1. Notify District office before setting surface casing.
2. Set surface casing by circulating cement to the top.
3. File completion forms ACO-1 with K.C.C. within 120 days of well spud date, following instructions on ACO-1, side 1, and including copies of wireline logs.
4. Notify District office 48 hours prior to old well workover or re-entry.
5. Prior to filing Intent, prepare a proposed plugging plan in case well is D & A, then obtain approval of plan when calling district office prior to setting surface pipe.
6. Submit plugging report (CP-4) to K.C.C. after plugging is completed.
7. Obtain an approved injection docket number before disposing of salt water.
8. Notify K.C.C. within 10 days when injection commences or terminates.

**A Regular Section of Land**  
**1 Mile = 5,280 Ft.**

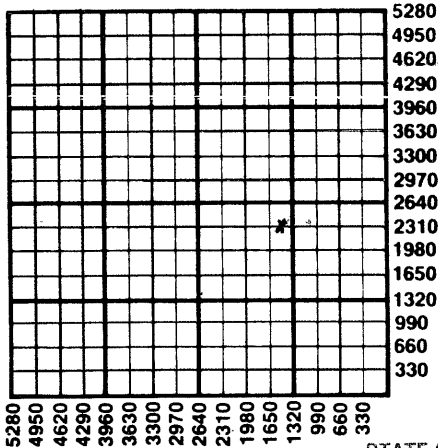

**RECEIVED.** If an alternate 2 completion, cement in the production pipe from  
 STATE CORPORATION COMMISSION any usable water to surface within 120 days of spud date.

**NOV 9 1987**  
 11-9-87  
 CONSERVATION DIVISION  
 Wichita, Kansas

State Corporation Commission of Kansas  
 Conservation Division  
 200 Colorado Derby Building  
 Wichita, Kansas 67202-1212  
 (316) 263-3238