

CARD MUST BE TYPED

State of Kansas  
NOTICE OF INTENTION TO DRILL  
(see rules on reverse side)

CARD MUST BE SIGNED

Starting Date: ..... 5 ..... 15 ..... 85 .....  
month day year

API Number 15- 153-20,612-00-00

OPERATOR: License # 7619

NE NE NE (location) Sec 22 Twp 4 S, Rge 33  East  West

Name Fred Gee

Address Box 602

City/State/Zip Eureka, Kansas 67045

Contact Person Fred Gee

Phone 316-583-5368

4950 Ft North from Southeast Corner of Section

330 Ft West from Southeast Corner of Section

(Note: Locate well on Section Plat on reverse side)

CONTRACTOR: License # 8682

Nearest lease or unit boundary line 330 feet.

Name Golden Eagle Drilling

County Rawlins

City/State McCook, Nebraska 69001

Lease Name Franklin Well# 1-22

Domestic well within 330 feet:  yes  no

Municipal well within one mile:  yes  no

Well Drilled For: Well Class: Type Equipment:

Oil  Swd  Infield  
 Gas  Inj  Pool Ext.  
 OWWO  Expl  Wildcat

Mud Rotary  
 Air Rotary  
 Cable

Depth to Bottom of fresh water 100 <sup>135</sup> feet

Lowest usable water formation Ogallala

Depth to Bottom of usable water ~~400~~ 200 feet

Surface pipe by Alternate: 1 ~~A~~ 2 ~~B~~

Surface pipe to be set 200 feet

Conductor pipe if any required ..... feet

Ground surface elevation 30.16 feet MSL

This Authorization Expires 12-10-85

Approved By 6-10-85 *[Signature]*

If OWWO: old well info as follows:

Operator .....

Well Name .....

Comp Date ..... Old Total Depth .....

Projected Total Depth 4500 feet

Projected Formation at TD miss

Expected Producing Formations LKC-Marmaton

I certify that we will comply with K.S.A. 55-101, et seq., plus eventually plugging hole to K.C.C. specifications.

Date 6-3-85 Signature of Operator or Agent

*[Signature]* Title


*[Signature]*  
MHC/LOHE 6-10-85

Must be filed with the K.C.C. five (5) days prior to commencing well  
 This card void if drilling not started within six (6) months of date received by K.C.C.

RECEIVED  
 STATE CORPORATION COMMISSION  
 JUN 10 1985 6-10-85  
 CONSERVATION DIVISION  
 Wichita, Kansas

**Important procedures to follow :**

**A Regular Section of Land**  
**1 Mile = 5,280 Ft.**

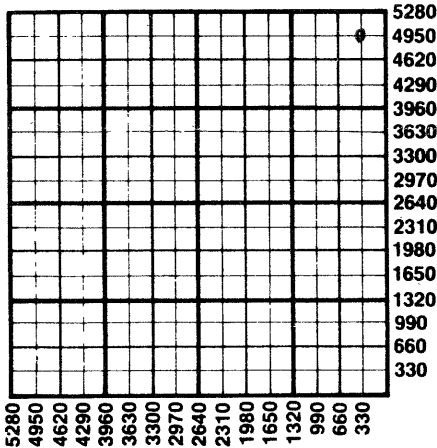

1. Notify District office before setting surface casing.
2. Set surface casing by circulating cement to the top.
3. File completion forms ACO-1 with K.C.C. within 90 days of well completion, following instructions on ACO-1, side 1, and including copies of wireline logs.
4. Notify District office 48 hours prior to old well workover or re-entry.
5. Prior to plugging, prepare a plugging plan, then obtain agreement from the appropriate district office for an approved plugging plan.
6. Submit plugging report (CP-4) to K.C.C. after plugging is completed.
7. Obtain an approved injection docket number before disposing of salt water.
8. Notify K.C.C. within 10 days when injection commences or terminates.
9. If an alternate 2 completion, cement in the production pipe from below any usable water to surface within 120 days of spud date.

**State Corporation Commission of Kansas**  
**Conservation Division**  
**200 Colorado Derby Building**  
**Wichita, Kansas 67202**  
**(316) 263-3238**