

STATE OF KANSAS
STATE CORPORATION COMMISSION

WELL PLUGGING RECORD

Give All Information Completely
Make Required Affidavit
Mail or Deliver Report to
Conservation Division
State Corporation Comm.
245 North Water
Wichita, KS 67202

Decatur County, Sec. 22 Twp. 4S Rge. 27 EX/W
Location as "NE/CNW $\frac{1}{4}$ SW $\frac{1}{4}$ " or footage from lines _____

NE NW NE
Lease Owner Liberty Enterprises, Inc.
Lease Name Winget Well No. #1


Office Address 308 West Mill Plainville, Ks. 67663
Character of Well (Completed as Oil, Gas or Dry Hole) _____
Dry Hole

Date Well completed June 4, 1979
Application for plugging filed June 4, 1979
Application for plugging approved June 4, 1979
Plugging commenced June 4, 4:00 P.M. 1979
Plugging completed June 4, 5:30 P.M. 1979

Reason for abandonment of well or producing formation _____
No Commercial Production
If a producing well is abandoned, date of last production 19 _____

Was permission obtained from the Conservation Division or its agents before plugging was commenced? yes

Name of Conservation Agent who supervised plugging of this well Gil Balthazor
Producing formation _____ Depth to top _____ Bottom _____ Total Depth of Well _____
Show depth and thickness of all water, oil and gas formations.

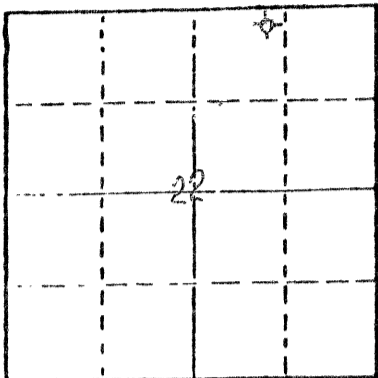

Locate well correctly on above Section Plot

OIL, GAS OR WATER RECORDS

CASING RECORD

FORMATION	CONTENT	FROM	TO	SIZE	PUT IN	PULLED OUT
surface casing	common	0	234.88'	8 5/8"	234.88'	0

Describe in detail the manner in which the well was plugged, indicating where the mud fluid was placed and the method or methods used in introducing it into the hold. If cement or other plugs were used, state the character of same and depth placed, from _____ feet to _____ feet for each plug set.

- Plug #1 @ 1200' with 70 sxs
- Plug #2 @ 220' with 20 sxs
- Plug #3 @ 40' with solid bridge and 10 sxs 50-50 poz and 15 sxs hulls 6% gel
- 5 sxs in rat hole

RECEIVED
STATE CORPORATION COMMISSION

JUN - 6 1979

6-6-79

(If additional description is necessary, use BACK of this report)

Name of Plugging Contractor Pioneer Drilling Company, Inc.
308 West Mill Plainville, Kansas 67663

STATE OF Kansas COUNTY OF Rooks, ss.
Charles G. Comeau (employee of owner) or (owner or operator)
of the above-described well, being first duly sworn on oath, says: That I have knowledge of the facts, statements, and matters herein contained and the log of the above-described well as filed and that the same are true and correct. So help me God.

(Signature) Charles G. Comeau
308 West Mill Plainville, Kansas 67663
(Address)

SUBSCRIBED AND SWORN TO before me this 5th day of June, 1979

Connie Jo Austin
Notary Public.

My commission expires _____

