


15-039-00480-00-00

STATE OF KANSAS  
STATE CORPORATION COMMISSION

Give All Information Completely -  
Make Required Affidavit  
Mail or Deliver Report to:  
Conservation Division  
State Corporation Commission  
800 Bitting Building  
Wichita, Kansas

WELL PLUGGING RECORD

Decatur County. Sec. 35 Twp. 4 Rge. ~~XXXXXX~~ 27 (W)  
Location as "NE/CNW/SW" or footage from lines NE NE NE  
Lease Owner Nye & Snell Drilling Company  
Lease Name Skubal Well No. 1  
Office Address Hays, Kansas  
Character of Well (completed as Oil, Gas or Dry Hole) Dry hole  
Date well completed 01/9/21/54 19  
Application for plugging filed 01/9/21/54 19  
Application for plugging approved 01/9/21/54 19  
Plugging commenced 01/9/21/54 19  
Plugging completed 01/9/21/54 19  
Reason for abandonment of well or producing formation \_\_\_\_\_

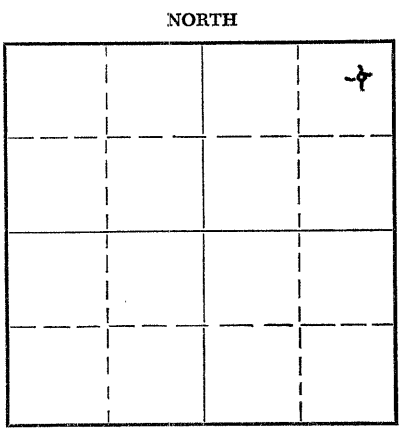

Locate well correctly on above  
Section Plat

If a producing well is abandoned, date of last production \_\_\_\_\_ 19  
Was production obtained from the Conservation Division or its agents before plugging was commenced? yes

Name of Conservation Agent who supervised plugging of this well Eldon Petty  
Producing formation none Depth to top \_\_\_\_\_ Bottom \_\_\_\_\_ Total Depth of Well 3880 Feet  
Show depth and thickness of all water, oil and gas formations.

OIL, GAS OR WATER RECORDS

CASING RECORD

FORMATION	CONTENT	FROM	TO	SIZE	PUT IN	PULLED OUT
Surface formation	water	-0-	525	8-5/8	525'	cemented 275 sacks

Describe in detail the manner in which the well was plugged, indicating where the mud fluid was placed and the method or methods used in introducing it into the hole. If cement or other plugs were used, state the character of same and depth placed, from \_\_\_\_\_ feet to \_\_\_\_\_ feet for each plug set.

Filled hole with heavy mud to 300 feet.  
Set bridge and plug at 300 feet and put 15 sacks cement on plug.  
Filled hole to 40 feet with heavy mud, put 1/2 sack hulls and plug at 40 feet.  
Put 10 sacks cement on top of plug, filling hole to bottom of cellar.

(If additional description is necessary, use BACK of this sheet)

Name of Plugging Contractor \_\_\_\_\_  
Address \_\_\_\_\_

STATE OF Kansas, COUNTY OF Ellis, ss.  
E. DeWitt Doley (employee of owner) or (owner or operator) of the above-described well, being first duly sworn on oath, says: That I have knowledge of the facts, statements, and matters herein contained and the log of the above-described well as filed and that the same are true and correct. So help me God.

(Signature) E. DeWitt Doley  
Hays, Kansas (Address)

SUBSCRIBED AND SWORN TO before me this 22nd day of January, 19 54

My commission expires May 9, 1957  
John L. Spiess Notary Public.

PLUGGING  
FILE SEC 35 T 4 R 27W  
BOOK PAGE 9 LINE 41